

DUCT & FITTING SYMBOLS			HVAC SYMBOLS & ABBREVIATIONS		GENERAL SYMBOLS	
DOUBLE LINE	SINGLE LINE	DESCRIPTION		DUCT WITH INTERNAL ACOUSTICAL INSULATION	(C)	CAP FOR FUTURE
SA		SUPPLY AIR		ACCESS DOOR	AD	POINT OF NEW CONNECTION
RA		RETURN AIR		VOLUME DAMPER	ARCH	REVISION NUMBER
OSA		OUTSIDE AIR		COMBINATION FIRE / SMOKE DAMPER	FSD	
EA		EXHAUST AIR		FIRE DAMPER	FD	
ERA		ECONOMIZER RELIEF AIR		VERTICAL FIRE DAMPER	FD	
12x12	12x12	RECTANGULAR DUCT SIZE FIRST NUMBER INDICATES VISIBLE DIMENSION AND SECOND NUMBER INDICATES HIDDEN DIMENSION. ALL DIMENSIONS ARE INCHES.		MOTORIZED DAMPER	GPM X"	PIPE SIZE AND FLOW TAG
12"Ø	12"Ø	ROUND DUCT DIAMETER		BACKDRAFT DAMPER		GENERAL BREAK
48x18Ø	48x18Ø	FLAT OVAL DUCT		OPPOSED BLADE DAMPER		ON DEMOLITION PLANS, INDICATES ITEMS TO BE REMOVED
		SUPPLY DUCT UP OR SECTION		PARALLEL BLADE DAMPER		KEYED NOTES
		SUPPLY DUCT DOWN OR SECTION AWAY		FLEXIBLE DUCT CONNECTION		EXISTING
		RETURN OR OSA DUCT UP OR SECTION				FUTURE
		RETURN OR OSA DUCT DOWN OR SECTION				
		EXHAUST DUCT UP OR SECTION				
		EXHAUST DUCT DOWN OR SECTION				
		TRANSITION				
		SQUARE TO ROUND TRANSITION				
		FLANGED TAKEOFF (RECTANGULAR DUCT)				
		LATERAL HIGH EFFICIENCY TAKE-OFF FITTING W / VD (SQR TO RND TAKEOFF FROM RECTANGULAR MAIN)				
		VD ON BRANCH DUCT				
		CONICAL 90° TAKE-OFF (ROUND / OVAL DUCT)				
		45° LATERAL TAKE-OFF (ROUND / OVAL DUCT)				
		DUCT SLOPE UP (RISE)				
		DUCT SLOPE DOWN (DROP)				
		END CAP				
		RECTANGULAR MITERED ELBOW W/ TURNING VANES				
		RECTANGULAR TEE- 90° MITERED ELBOWS W/ TURNING VANES				
		90° OR 45° LONG RADIUS ELBOW, R=1.5 DIA OR WIDTH (ROUND OR RECTANGULAR DUCT)				
		D or W				

NOTE: ABBREVIATIONS AND SYMBOLS ARE ARCSINE ENGINEERING STANDARDIZED SYMBOL LEGENDS, AS SUCH, ALL SYMBOLS SHOWN MAY NOT APPEAR ON OR WITHIN THIS SET OF CONTRACT DOCUMENTS.

HVAC ABBREVIATIONS	
ACFM	AIR CHANGES PER MINUTE
ACH	AIR CHANGES PER HOUR
AD	ACCESS DOOR
AFF	ABOVE FINISH FLOOR
AHU	AIR HANDLING UNIT
AL	ALUMINUM
AP	ACCESS PANEL
ARCH	ARCHITECT OR ARCHITECTURAL
ATD	AIR TRANSFER DUCT
BD	BACKDRAFT DAMPER
BLDG	BUILDING
BM	BEAM
BOD	BOTTOM OF DUCT
BOP	BOTTOM OF PIPE
BOS	BOTTOM OF STEEL
BTU	BRITISH THERMAL UNIT
CDV	CLOTHES DRYER VENT
CFH	CUBIC FEET PER HOUR
CFM	CUBIC FEET PER MINUTE
CLG	CEILING
CONSTR	CONSTRUCTION
CR	CONDENSATE RETURN (STEAM)
CWS	CHILLED WATER SUPPLY
CWR	CHILLED WATER RETURN
CV	CONSTRAINT VOLUME
DB	DRY BULB
DIA	DIAMETER
DN	DOWN
DWG	DRAWING
DX	DIRECT EXPANSION (REFRIGERATION)
EA	EXHAUST AIR
EAT	ENTERING AIR TEMPERATURE
EC	ELECTRICAL CONTRACTOR
ELEV	ELEVATION
ERA	ECONOMIZER RELIEF AIR
ESP	EXTERNAL STATIC PRESSURE
EWT	ENTERING WATER TEMPERATURE
EXH	EXHAUST
'F	FAHRENHEIT
FC	FLEXIBLE CONNECTION
FD	FIRE DAMPER
FLA	FULL LOAD AMPS
FLR	FLOOR
FOB	FLAT ON BOTTOM
FOT	FLAT ON TOP
FFM	FEET PER MINUTE
FSD	COMBINATION FIRE / SMOKE DAMPER
GALV	GALVANIZED STEEL
GC	GENERAL CONTRACTOR
GM	GAS METER
GPM	GALLONS PER MINUTE
GRD	GRILLES, REGISTERS, DIFFUSERS
H	HUMIDISTAT
HDPE	HIGH-DENSITY POLYETHYLENE
HEPA	HIGH EFFICIENCY PARTICULATE AIR
HP	MOTOR HORSEPOWER
HVAC	HEATING, VENTING, AND CONDITIONING
HWHS	HOT WATER HEATING SUPPLY
HWHR	HOT WATER HEATING RETURN
LB(S)	POUND, POUNDS
LAT	LEAVING AIR TEMPERATURE
LWT	LEAVING WATER TEMPERATURE
MA	MIXED AIR
MAX	MAXIMUM
MBH	THOUSAND BTU PER HOUR
MC	MECHANICAL CONTRACTOR
MCA	MINIMUM CIRCUIT CAPACITY
MECH	MECHANICAL
MFR	MANUFACTURER
MFS	MAXIMUM FUSE SIZE
MIN	MINIMUM
MOCP	MAXIMUM OVERCURRENT PROTECTION
NC	NORMALLY CLOSED
NG	NATURAL GAS
NIC	NOT IN CONTRACT
NO	NORMALLY OPEN
NTS	NOT TO SCALE
OBDD	OPPOSED BLADE DAMPER ON CENTER
OC	OUTSIDE AIR
OSA	OUTSIDE AIR
OMSC	2014 OREGON MECHANICAL SPECIALTY CODE
OSSC	2014 OREGON STRUCTURAL SPECIALTY CODE
PBD	PARALLEL BLADE DAMPER
PD	PRESSURE DRIP
PSI	POUNDS PER SQUARE INCH
PT	PRESSURE / TEMPERATURE PLUG
PVC	POLYVINYL CHLORIDE
RA	RETURN AIR
RECT	RECTANGULAR
RPM	REVOLUTIONS PER MINUTE
REQ'D	REQUIRED
SA	SUPPLY AIR
SCFM	STANDARD AIR - CUBIC FEET PER MINUTE
SEC	SECTION
SF or SQ FT	SQUARE FEET
SIM	SIMILAR
SM	SHEET METAL
SMACNA	SHEET METAL AND AIR CONDITIONING CONTRACTORS NATIONAL ASSOCIATION
SP	STATIC PRESSURE
SPEC	SPECIFICATION OR SPECIFIED
SS	STAINLESS STEEL
STD	STANDARD
STM	STEAM
T	THERMOSTAT
TA	TRANSFER AIR
TC	TEMPERATURE CONTROLS
TEMP	TEMPERATURE
TOS	TOP OF STEEL
TYP	TYPICAL
UNO	UNLESS NOTED OTHERWISE
VAV	VARIABLE AIR VOLUME
VD	VOLUME DAMPER
VFD	VARIABLE FREQUENCY DRIVE
WB	WET BULB
W/	WITH
WG	WATER GAUGE

- GENERAL NOTES
1.

PROVIDE ALL LABOR, MATERIALS, AND EQUIPMENT NECESSARY TO CONSTRUCT A COMPLETE, OPERATIONAL HVAC SYSTEM FOR THE ENTIRE PROJECT AS SHOWN ON THESE DRAWINGS, INCLUDING ALL NECESSARY FEES AND PERMITS.
2.

THE ENTIRE INSTALLATION SHALL CONFORM TO THE REQUIREMENTS OF THE MOST RECENTLY ADOPTED BUILDING CODE, MECHANICAL CODE, PLUMBING CODE, ELECTRICAL CODE, AND ALL OTHER APPLICABLE CITY, COUNTY, STATE, AND FEDERAL CODES AND REGULATIONS IN EFFECT AT THE DATE OF THE BID. WHEREVER THE REQUIREMENTS OF THE SPECIFICATIONS OR DRAWINGS EXCEED THOSE OF THE ITEMS ABOVE, THE REQUIREMENTS OF THE SPECIFICATIONS OR DRAWINGS SHALL GOVERN.
3.

WHERE THE MECHANICAL WORK WILL BE INSTALLED IN CLOSE PROXIMITY TO, OR WILL INTERFERE WITH, WORK OF OTHER TRADES, THE CONTRACTOR SHALL ASSIST IN WORKING OUT SPACE CONDITIONS TO MAKE A SATISFACTORY ADJUSTMENT PRIOR TO COMMENCING WORK. IF THE CONTRACTOR INSTALLS HISHER WORK BEFORE COORDINATING WITH OTHER TRADES, SO AS TO CAUSE ANY INTERFERENCE WITH WORK OF OTHER TRADES, THE CONTRACTOR SHALL MAKE THE NECESSARY CHANGES IN HISHER WORK TO CORRECT THE CONDITION WITHOUT EXTRA CHARGE.
4.

THE DRAWINGS SHOW THE GENERAL DESIGN, ARRANGEMENTS AND THE EXTENT OF THE SYSTEM. IT SHALL BE THE WORK OF THE CONTRACTOR TO MAKE SUCH ALTERATIONS AS MAY BE NECESSARY TO MAKE THE SYSTEM COMPLETE AND OPERATIONAL IN ACCORDANCE WITH THE DESIGN INTENT. MAJOR DEVIATIONS SUCH AS CHANGES IN COMPONENT SIZES, WEIGHTS, QUANTITIES, OR MATERIAL REQUIRE PRIOR APPROVAL BY THE CONSULTING ENGINEER.
5.

CONTRACTORS AND SUB-CONTRACTORS SHALL CAREFULLY REVIEW THE CONSTRUCTION DOCUMENTS. INFORMATION REGARDING THE COMPLETE WORK IS DISPERSED THROUGHOUT THE DOCUMENT SET AND CANNOT BE ACCURATELY DETERMINED WITHOUT REFERENCE TO THE COMPLETE DOCUMENT SET.
6.

THE WORKING DRAWINGS ARE DIAGNOSTIC. BECAUSE OF THE SMALL SCALE OF THE DRAWINGS, THEY DO NOT SHOW EVERY OFFSET, BEND OR ELBOW NECESSARY FOR THE COMPLETE INSTALLATION IN THE SPACE PROVIDED. ALL LOCATIONS FOR HVAC EQUIPMENT AND PIPING SHALL BE CHECKED AND COORDINATED WITH THE ARCHITECTURAL, MECHANICAL, STRUCTURAL AND ELECTRICAL DRAWINGS.
7.

SPACE ABOVE ALL CEILINGS IS EXTREMELY LIMITED. CONTRACTORS SHOULD EXPECT AN EXTRA-ORDINARY NUMBER OF OFFSETS, TRANSITIONS, ETC. (WHICH MAY OR MAY NOT BE SHOWN ON THE DRAWINGS) WILL BE REQUIRED. CAREFUL COORDINATION IS REQUIRED WITH ALL TRADES BEFORE ANY PIPE, DUCT, OR EQUIPMENT IS ORDERED, FABRICATED, AND/OR INSTALLED. ANY CONFLICTS AND/OR CHANGES FOUND DURING INSTALLATION THAT RESULT FROM LACK OF COORDINATION BY THE CONTRACTORS DURING THE SHOP DRAWING PROCESS ARE THE RESPONSIBILITY OF THE CONTRACTOR.
8.

THE DRAWINGS AND SPECIFICATIONS HAVE BEEN PREPARED TO SUPPLEMENT EACH OTHER AND THEY SHALL BE INTERPRETED AS AN INTEGRAL UNIT WITH THE ITEMS SHOWN ON ONE AND NOT THE OTHER BEING FURNISHED AND INSTALLED AS THOUGH SHOWN AND CALLED OUT IN BOTH.
9.

DETAILS: THE CONTRACTOR IS RESPONSIBLE TO REVIEW AND USE WHERE APPROPRIATE ALL OF THE MECHANICAL DETAILS SHOWN ON THE DRAWINGS. DETAILS MAY OR MAY NOT BE CALLED OUT ON THE DRAWINGS WITH SYMBOLS OR KEYED NOTES. ANY CHANGES RESULTING FROM FAILURE TO INSTALL THE MECHANICAL SYSTEM WITHOUT USING THE INCLUDED DETAILS IS THE RESPONSIBILITY OF THE CONTRACTOR.
10.

PIPING SCHEMATICS: THE CONTRACTOR IS RESPONSIBLE TO REVIEW THE PIPING SCHEMATICS INCLUDED WITH THE DRAWINGS FOR PIPING CONNECTIONS TO ALL MECHANICAL EQUIPMENT. THE PIPING SCHEMATICS SHOW DETAILED CONNECTIONS INCLUDING NECESSARY VALVES, FITTINGS, PRESSURE AND TEMPERATURE GAUGES, ETC., THAT ARE NOT SHOWN ON THE PIPING PLANS. ANY CHANGES RESULTING FROM FAILURE TO INSTALL THE MECHANICAL SYSTEM WITHOUT USING THE INCLUDED PIPING SCHEMATICS IS THE RESPONSIBILITY OF THE CONTRACTOR.
11.

ALL DUCTWORK SHALL BE GALVANIZED STEEL, ROUND OR RECTANGULAR. GAUGE, REINFORCEMENT, AND SUPPORT SHALL BE PER SMACNA DUCT CONSTRUCTION STANDARDS. UNLESS NOTED OTHERWISE, SUPPLY AIR DUCTS SHALL BE CONSTRUCTED TO +2" PRESSURE STANDARD, RETURN DUCTS SHALL BE CONSTRUCTED TO -1" PRESSURE STANDARD. SEAL ALL DUCTS TO SMACNA CLASS "B" STANDARDS. INSTALL IN CONFORMANCE TO MECHANICAL CODES. FLEXIBLE DUCTS SHALL BE INSULATED NONMETALLIC, FORM "NM-L", MAXIMUM LENGTH OF 5'-0" AT DIFFUSER OR GRILLE CONNECTION. PROVIDE BUTTERFLY BALANCING DAMPERS WHERE SHOWN OR REQUIRED, ROUND OR RECTANGULAR, GALVANIZED SHEET METAL, WITH EXTERNAL INDICATING QUADRANT AND SETSCREW. PROVIDE TURNING VANES FOR ALL RECTANGULAR ELBOWS.
12.

SHEET METAL DUCT SIZES SHOWN ARE NET CLEAR INSIDE DIMENSIONS. WHEN INTERNAL INSULATION IS REQUIRED, DUCT SIZE SHALL BE INCREASED TO PROVIDE NET CLEAR DIMENSIONS INDICATED.
13.

CONTRACTOR SHALL INSTALL EXPOSED DUCTWORK IN A NEAT AND CLEAN MANNER AND UTILIZE SPIRAL DUCTWORK WHERE POSSIBLE. SCRATCHED OR DENTED DUCTWORK SHALL BE REPLACED. THE ARCHITECT AND/OR ENGINEER SHALL BE THE FINAL JUDGE OF ACCEPTANCE.
14.

ALL PIPING SERVING AS PART OF A HEATING OR COOLING SYSTEM SHALL BE INSULATED PER SECTION 503.2.8 OF THE OESC.
15.

DUCTWORK INSULATION:

A.

ALL SUPPLY AIR DUCTS IN UNCONDITIONED SPACES AND PLENUMS (ABOVE CEILINGS, WITHIN CHASES, SHAFTS, OR MECHANICAL ROOMS) AND WITHIN THE BUILDING ENVELOPE SHALL BE INSULATED WITH 2" THICK FIBERGLASS DUCT WRAP FACED WITH OUTER FOIL BLANKET, OR LINED WITH 1-1/2" THICK, COATED FIBERGLASS INSULATION, MINIMUM INSTALLED R-VALUE OF 5.

B.

ALL OUTSIDE AIR DUCTS IN UNCONDITIONED SPACES AND PLENUMS (ABOVE CEILINGS, WITHIN CHASES, SHAFTS, OR MECHANICAL ROOMS) AND WITHIN THE BUILDING ENVELOPE SHALL BE INSULATED WITH 1-1/2" THICK, 34 LB DENSITY, FIBERGLASS DUCT WRAP FACED WITH OUTER FOIL BLANKET, OR LINED WITH 1/2" THICK, COATED FIBERGLASS INSULATION, MINIMUM INSTALLED R-VALUE OF 1.9.

C.

ALL OUTSIDE AIR DUCTS WITHIN FULLY CONDITIONED SPACES SHALL BE INSULATED WITH 1-1/2" THICK, 34 LB DENSITY, FIBERGLASS DUCT WRAP FACED WITH OUTER FOIL BLANKET, OR LINED WITH 1" THICK, COATED FIBERGLASS INSULATION, MINIMUM INSTALLED R-VALUE OF 3.5.

D.

ALL EXHAUST AIR DUCTWORK SHALL BE INSULATED BETWEEN THE FAN OUTLET AND WALL/ROOF OUTLET WITH 1-1/2" THICK, 34 LB DENSITY, FIBERGLASS DUCT WRAP FACED WITH OUTER FOIL BLANKET.

E.

EXPOSED SUPPLY AND RETURN AIR DUCTWORK WITHIN CONDITIONED SPACES NEED NOT BE INSULATED UNLESS NOTED OTHERWISE.
16.

PROVIDE FLEXIBLE DUCT CONNECTORS WHERE DUCTS CONNECT TO AIR HANDLING EQUIPMENT.
17.

DUCT SMOKE DETECTORS:

A.

UPON ACTIVATION, THE SMOKE DETECTORS SHALL SHUT DOWN ALL OPERATIONAL CAPABILITIES OF THE AIR DISTRIBUTION SYSTEM IN ACCORDANCE WITH THE LISTING AND LABELING OF APPLIANCES USED IN THE SYSTEM.

B.

WHEN A FIRE ALARM SYSTEM IS PROVIDED THE DUCT SMOKE DETECTORS SHALL BE CONNECTED TO THE BUILDING'S FIRE ALARM CONTROL PANEL.

C.

PROVIDE REMOTE TEST AND RESET CAPABILITIES FOR ALL DUCT DETECTORS.
18.

THE STRUCTURE SHOWN ON ALL DETAILS MAY OR MAY NOT PERTAIN TO A PORTION OR ANY PORTION OF THE BUILDING. COORDINATE MOUNTING REQUIREMENTS WITH ARCHITECTURAL AND STRUCTURAL DRAWINGS.
19.

ALL EQUIPMENT SHALL PROVIDE THE SCHEDULED PERFORMANCE AT THE SITE ALTITUDE OF 1950 FT. ALL MANUFACTURERS' SUBMITTAL DATA SHEETS SHALL SHOW PERFORMANCE AT SITE ALTITUDE.
20.

ALL EQUIPMENT SHALL BE INSTALLED IN STRICT ACCORDANCE WITH THE EQUIPMENT MANUFACTURER'S RECOMMENDATIONS. PROVIDE ALL FITTINGS, TRANSITIONS, VALVES, DAMPERS, AND OTHER DEVICES AND ACCESSORIES REQUIRED FOR A COMPLETE, WORKABLE INSTALLATION.
21.

ALL MECHANICAL EQUIPMENT, DUCTWORK, AND PIPING MUST BE SEISMICALLY BRACED FOR THE SITE SPECIFIC SEISMIC DESIGN CATEGORY AND SEISMIC USE GROUP, IN ACCORDANCE WITH THE LATEST ADOPTED EDITIONS OF THE OSSC, OMSC, ASHRAE, AND SMACNA. COORDINATE SITE SPECIFIC SEISMIC REQUIREMENTS WITH STRUCTURAL ENGINEER AND/OR ARCHITECT.
22.

THE MECHANICAL CONTRACTOR SHALL FURNISH ALL REQUIRED MOTORS AND STARTERS. DISCONNECTS, WHEN NOT A PART OF THE EQUIPMENT, WILL BE FURNISHED BY THE ELECTRICAL CONTRACTOR.
23.

EXISTING INTERIOR PIPING, EQUIPMENT, AND DUCTWORK HAS BEEN LOCATED IN AN APPROXIMATE WAY ONLY. THE CONTRACTOR SHALL VERIFY LOCATIONS AND POINTS OF CONNECTION AND PIPE ROUTING THROUGH EXISTING CONDITIONS PRIOR TO COMMENCING WORK.
24.

IF CONTRACTOR ENCOUNTERS MATERIAL WHICH MAY CONTAIN ASBESTOS, IMMEDIATELY STOP WORK IN THIS AREA AND NOTIFY THE OWNER.
25.

THE CONTRACTOR IS RESPONSIBLE FOR HVAC EQUIPMENT CHECK-IN, SAFEKEEPING, AND DAMAGE.
26.

DO NOT ROUTE DUCTS AND PIPES ABOVE ELECTRICAL PANELS. ALL ELECTRICAL PANELS MUST HAVE CLEAR ACCESS SPACE IN FRONT OF PANEL 4'-0" DEEP AND 6'-6" HIGH. DO NOT ROUTE DUCT AND PIPES IN ELECTRICAL ROOMS, EXCEPT DUCTS AND PIPES SERVING THE ROOM.
27.

COORDINATE EXACT LOCATIONS OF CEILING DIFFUSERS AND GRILLES WITH ARCHITECTURAL REFLECTED CEILING PLAN.
28.

ALL FIRE DAMPERS SHOWN ARE 1-1/2 HOUR UNLESS OTHERWISE NOTED. INSTALL IN COMPLIANCE WITH MANUFACTURER'S U.L. LISTING.
29.

PROVIDE CEILING ACCESS PANELS AS REQUIRED WHERE MECHANICAL EQUIPMENT, VALVES, VAV BOXES, FIRE DAMPERS, ETC. ARE LOCATED ABOVE INACCESSIBLE CEILINGS. MINIMUM ACCESS PANEL SIZE IS 24"x24" UNLESS OTHERWISE NOTED.
30.

TWO OPERATING AND MAINTENANCE MANUALS SHALL BE PROVIDED IN HARD BACK LOOSE LEAF BINDERS. MANUALS SHALL CONTAIN PRODUCT CUT SHEETS AND OPERATING AND MAINTENANCE INSTRUCTIONS ON ALL EQUIPMENT, ACCESSORIES, FIXTURES, VALVES, ETC., PROVIDED FOR THE PROJECT. PROVIDE LIST OF EQUIPMENT WITH ALL NAMEPLATE DATA INCLUDING TAG #, MODEL NUMBER, SERIAL NUMBER, AND NAME OF LOCAL REPLACEMENT PARTS SUPPLIER.
31.

UPON COMPLETION OF THE WORK, REMOVE ALL SURPLUS MATERIALS AND RUBBISH. MAKE ALL REQUIRED PATCHING AND REPAIRS OF OTHER TRADES' WORK DAMAGED BY THE MECHANICAL CONTRACTOR, AND LEAVE THE PREMISES IN A CLEAN, ORDERLY CONDITION.
32.

THE MECHANICAL CONTRACTOR SHALL OPERATE THE SYSTEM AND DEMONSTRATE ALL ASPECTS TO THE ENGINEER AND/OR OWNER, TO PROVE ITS OPERATION. ALL FILTERS USED DURING CONSTRUCTION SHALL BE REPLACED PRIOR TO THE TEST RUN PERIOD.
33.

THE CONTRACTOR SHALL, DURING CONSTRUCTION, MAINTAIN A SET OF AS-BUILT REDLINED RECORD DRAWINGS AT THE PROJECT SITE. ALL CHANGES IN LAYOUT, ROUTING, EQUIPMENT, COMPONENTS, AND ACCESSORIES SHALL BE RECORDED.

SHEET LIST

- M1.0

MECHANICAL LEGEND AND NOTES
- M1.1

MECHANICAL SCHEDULES
- M2.1

BASEMENT MECHANICAL DEMOLITION PLAN
- M2.2

LEVEL 1 MECHANICAL DEMOLITION PLAN
- M2.3

LEVEL 2 MECHANICAL DEMOLITION PLAN
- M3.1

BASEMENT MECHANICAL PLAN- NORTH
- M3.2

BASEMENT MECHANICAL PLAN- SOUTH
- M3.3

BASEMENT MECHANICAL PIPING PLAN
- M3.4

LEVEL 1 MECHANICAL PLAN
- M3.5

LEVEL 2 MECHANICAL PIPING PLAN AND SECTIONS
- M4.1

MECHANICAL DETAILS
- M4.2

MECHANICAL DETAILS


kistler+small+white

architects

66 WATER STREET
SUITE 101
ASHLAND, OR
97520
TEL.: 541.488.8200

THESE DRAWINGS SHALL
BE USED FOR:
CONSTRUCTION
BIDDING
RECORDATION
CONVEYANCE
ISSUANCE OF A PERMIT

PHASE 2
BID SET

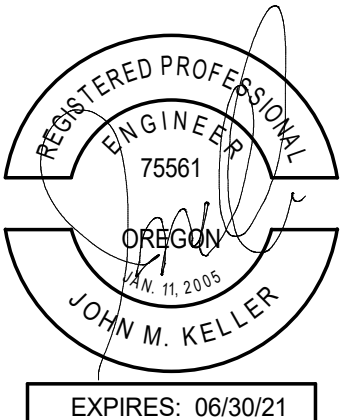

ArcSine engineering

A full-spectrum engineering company

950 Executive Way | Redding, CA 96002 | (530)222-7204
1236 Oak Drive | Medford, OR 97501 | (541)942-2188
www.arcsine.com

BRITT HALL - RENOVATION
SEISMIC UPGRADE / OHSU RENOVATION - PHASE 2
SOUTHERN OREGON UNIVERSITY
SISKIYOU BOULEVARD, ASHLAND OREGON, 97520

REVISIONS
2 IB-1 07.24.2020

MECHANICAL
LEGEND AND
NOTES

PROJECT NO.: 1905
ISSUE DATE: 02.13.2020
SHEET:

M1.0

EXHIBIT B TO BRITT HALL COMMISSIONING RFP 2021-XX

AIR HANDLING UNIT SCHEDULE																																					
TAG	TOTAL CFM	OUTSIDE AIR CFM	MIN OUTSIDE AIR CFM	COOLING COIL								HEATING COIL					FILTERS			SUPPLY FAN			RETURN/RELIEF FAN					ELECTRICAL				MANUFACTURER	MODEL	DIM. L x W x H (IN.)	OPERATING WEIGHT	NOTES	
				GPM	TOTAL MBH	SENS MBH	EWI/ LWT	EDB	EWB	LDB	LWB	HEATING CFM	GPM	TOTAL MBH	EWI/ LWT	EDB	LDB	TYPE	EFF.	BHP	MOTOR HP	EXT.SP	CONTROL TYPE	CFM	BHP	MOTOR HP	EXT SP	CONTROL TYPE	VOLTS	PHASE	MCA						MOCP
AH-1	11,000	2,500	960	32.4	292.6	276.1	45/63	79.5	63.6	56	54	5,500	13.8	207	180/160	46.6	80	2" PLEAT	MERV13	11.2	2 @ 7.2	2.5	VFD	SEPARATE RETURN FAN, SEE FAN SCHEDULE					208	3	38.6	60	TRANE	CSAA021	151 x 80 x 53	2,500	1,2
AH-2	4,000	970	305	11.5	104.1	102.2	45/63	80.4	63.4	56	54	2,000	4.5	66.5	180/160	48	80	2" PLEAT	MERV13	3.7	7.6	2.2	VFD	4,000	2.4	4.2	0.75	VFD	208	3	22.8 & 12.13	40 & 20	TRANE	CSAA008	163 x 51 x 38	1,700	1,2,3
AH-3	3,000	625	225	9.5	85.4	83.9	45/63	82.8	64.2	56	55	1,500	6.1	91.0	180/160	50	80	2" PLEAT	MERV13	3.0	4.2	2.6	VFD	3,000	1.9	4.2	1.00	VFD	208	3	2 @ 12.13	2 @ 20	TRANE	CSAA008	148 x 44 x 36	1,700	1,2,3
AH-4	9,000	1,070	470	27.4	228.0	215.9	45/63	80.0	63.9	56	55	9,000	22.2	332.7	180/160	58.4	95	2" PLEAT	MERV13	6.1	2 @ 7.2	1.8	VFD	9,000	2.2	4.2 @ 7.4	0.75	VFD	208	3	22.8 & 12.13	40 & 20	TRANE	CSAA021	183 x 80 x 53	2,425	1,2
AH-5	2,450	430	430	7.0	62.7	62.7	45/63	79.5	60.8	55	51	1,200	3.1	45.9	180/150	53	80	2" PLEAT	MERV13	1.6	2.3	1.8	VFD	2,450	0.8	4.2	0.50	VFD	208	3	17.3	20	TRANE	CSAA008	142 x 44 x 41	2,085	1,2
NOTES: 1. PROVIDE DIRECT DRIVE, MOTOR OIL IMPELLER TYPE FANS, OUTSIDE AIR DAMPERS WITH AIRFLOW MEASUREMENT 2. PROVIDE WITH SHIPPING SPLITS AS REQUIRED TO FIT THROUGH EXTERIOR DOORS. COORDINATE WITH ARCHITECTURAL PLANS AND GC. 3. ALTERNATE 1. 4. ROOF MOUNTED. PROVIDE 14" CURB, PIPING VESTIBULE, EXHAUST AND INTAKE AIR HOODS, SINGLE POINT POWER																																					

4-PIPE FAN COIL UNIT SCHEDULE																									
TAG	TOTAL CFM	MIN. OUTSIDE AIR (CFM)	COOLING COIL						HEATING COIL						SUPPLY FAN				ELECTRICAL				MANUFACTURER	MODEL	WEIGHT
			GPM	EWT	TOTAL (MBH)	SENS (MBH)	EDB	EWB	GPM	EWT	TOTAL (MBH)	EDB	LDB	MOTOR HP	EXT. S.P.	CONTROL TYPE	VOLTS	PHASE	MCA	MOCP					
FC-1	480	55	1.7	45	11.2	10.0	74	62	0.6	180	16.4	66	99	1/2	0.50	CONSTANT VOL	115	1	9.3	15	TRANE	BCCD024	160		
FC-2	850	0	3	45	19.7	18.4	75	62	0.8	180	24	70	98	1/2	0.75	CONSTANT VOL	115	1	9.3	15	TRANE	BCCD036	185		
NOTES: 1. VERTICAL FAN COIL WITH BOTTOM RETURN 2. PROVIDE STAINLESS STEEL DRAIN PAN, ECM MOTOR, 2" MERV 13 PLEATED FILTERS																									


STEAM TO WATER HEAT EXCHANGER SCHEDULE																		
TAG	LOCATION	SERVICE	CIRCULATING FLUID (TUBE) SIDE						STEAM PSIG		CONTROL VALVE (LBS/HR)	MIN SQFT SURFACE AREA	TRAP (LBS/HR)	WEIGHT	MANUFACTURER	MODEL	NOTES	
			FLUID	GPM	TEMP IN	TEMP OUT	MAX. PRESS. DROP, FT	FOULING FACTOR	NO. PASSES	ENTERING CONTROL VALVE								ENTERING CONVERTOR
HEX-1	BASEMENT	HHW	H2O	140	150	180	15	0.0005	2	15	3	2,080	68	2,080		BELL & GOSSETT	QSU-88-2	
NOTES:																		

EXPANSION TANK SYSTEM SCHEDULE																						
TAG	SYSTEM	TANK TYPE	APPROX. SYSTEM VOL (GAL)	SYSTEM TEMP RANGE F		INITIAL PRESSURE IN TANK	PRV FILL PRESSURE AT TANK	MAX. OPERATING PRESSURE		MIN. VOL (GAL)	AIR SEPARATOR				PIPE SIZE TO TANK	COLD WATER FILL SIZE	MAX. OPERATING WEIGHT		MANUFACTURER	TANK MODEL	AIR SEPARATOR MODEL	NOTES
				MIN.	MAX.			RELIEF VALVE	AT TANK		SIZE	GPM	MAX. P.D.	STRAINER (Y/N)			TANK	AIR SEP				
ET-1	HEATING	COMPRESSION	520	45	200	12	12	80	45	60	3"	150	5'	Y	1"	3/4"	616	155	B & G	116033	R-3N	NOTES: 1. ALL PRESSURES IN PSIG.


PUMP SCHEDULE															
TAG	SYSTEM	CIRCULATING FLUID				% EFF.	BHP	CONTROL TYPE	ELECTRICAL			WEIGHT	MANUFACTURER	MODEL	NOTES
		FLUID TYPE	GPM	PUMP HEAD	TEMP.				MOTOR H.P.	VOLTS	PHASE				
P-1	HHW	H2O	75	60	180	56%	1.95	VARIABLE SPEED	3	208	3	216	BELL & GOSSETT	e-1510 1.25BC	1
P-2	HHW	H2O	75	60	180	56%	1.95	VARIABLE SPEED	3	208	3	216	BELL & GOSSETT	e-1510 1.25BC	1
P-3	FUTURE HHW	H2O	75	60	180	56%	1.95	VARIABLE SPEED	3	208	3				2
NOTES: 1. PROVIDE SUCTION DIFFUSER AND VFD RATED MOTOR 2. P-3 IS A FUTURE PUMP, LISTED HERE FOR INFO ONLY															

LOUVER SCHEDULE								
TAG	SYSTEM	TYPE	SIZE	CFM	MAX. AIR PD	MANUFACTURER	MODEL	NOTES
L-1	AH-2 INTAKE	DRAINABLE BLADE	44x40	4,000	0.08	GREENHECK	ESD-403	1,2,3
L-2	AH-2 RELIEF	DRAINABLE BLADE	36x33	4,000	0.15	GREENHECK	ESD-403	1,3
L-3	AH-3 INTAKE	DRAINABLE BLADE	32x30	3,000	0.16	GREENHECK	ESD-403	1,3
L-4	AH-3 RELIEF	DRAINABLE BLADE	32x34	3,000	0.10	GREENHECK	ESD-403	1,3
NOTES: 1. BAKED ENAMEL FINISH. COLOR SELECTED BY ARCHITECT FROM MANUFACTURER'S STANDARD COLORS.								
2. FIELD VERIFY EXISTING WINDOW OPENING DIMENSIONS PRIOR TO ORDERING LOUVER.								
3. ALTERNATE 1								

OUTSIDE AIR SCHEDULE													
SYSTEM TAG	SPACE TYPE	AREA SQ.FT. (A ₂)	ZONE POP. (P ₂)	CFM/ PERSON (R _p)	CFM/ SQFT (R _a)	P ₂ *R _p	A ₂ *R _a	EFFECTIVE-NESS (E ₂)	ZONE OA (Voz)	AIRFLOW TO ZONE		PRIMARY OA FRACTION (Z _p)	
										PRIMARY (Vp ₂)	MIN (Vp _{2m})		
AH-1	CONFERENCE / MEETING	314	12	5	0.06	60	18.84	0.8	99	575	115	0.86	
	OFFICE SPACE	92	0.46	5	0.06	2.3	5.52	0.8	10	130	30	0.33	
	OFFICE SPACE	92	0.46	5	0.06	2.3	5.52	0.8	10	80	20	0.49	
	OFFICE SPACE	135	0.675	5	0.06	3.375	8.1	0.8	14	160	35	0.41	
	MAIN ENTRY LOBBIES	1,073	10.73	5	0.06	53.65	64.38	0.8	148	690	140	1.05	
	LOCKER/DRESSING ROOMS	125	0	0	0	0	0	0.8	0	50	10	NA	
	STORAGE ROOMS	159	0.318	5	0.06	1.59	9.54	0.8	14	120	25	0.56	
	STORAGE ROOMS	100	0.2	5	0.06	1	6	0.8	9	50	25	0.35	
	STORAGE ROOMS	67	0.114	5	0.06	0.67	3.42	0.8	5	30	15	0.33	
	LECTURE CLASSROOM	1,764	35	7.5	0.06	262.5	105.84	0.8	460	1,320	265	1.74	
	LECTURE CLASSROOM	961	12	7.5	0.06	90	57.66	0.8	185	720	145	1.27	
	OFFICE SPACE	185	0.925	5	0.06	4.625	11.1	0.8	20	140	30	0.66	
	OFFICE SPACE	114	0.57	5	0.06	2.85	6.84	0.8	12	220	45	0.27	
	OFFICE SPACE	204	1.02	5	0.06	5.1	12.24	0.8	22	150	30	0.72	
	RECEPTION AREAS	5,402	80	5	0.06	400	324.12	1	724	4,050	810	0.89	
	COMPUTER LAB	1,800	50	10	0.12	500	216	1	716	2,460	495	1.45	
	TOTALS:	12,577	204.472							10,945	2,235		
	SYSTEM POPULATION (P _s)										150		
	DIVERSITY (D)										0.7		
	UNCORRECTED OSA (V _{ou})										1875		
	MAX Z _p										1.74		
	VENT EFF. (Ev)										0.30		
	MIN. OUTSIDE AIR (Vot), CFM										2,481		
AH-2	LECTURE CLASSROOM	992	50	7.5	0.06	375	59.52	0.8	543	2,100	550	0.99	
	COPY, PRINTING	183	0.772	5	0.06	3.86	11.58	0.8	19	145	29	0.67	
	CORRIDORS	104	0	0	0.06	0	6.24	0.8	8	100	20	0.39	
	LAUNDRY ROOMS, CENTRAL	166	1.66	5	0.12	8.3	19.92	0.8	35	125	35	1.01	
	CLASSROOMS (AGE 9 PLUS)	176	6.16	10	0.12	61.6	21.12	0.8	103	270	100	1.03	
	CORRIDORS	795	0	0	0.06	0	47.7	0.8	60	400	80	0.75	
	OFFICE SPACE	159	0.795	5	0.06	3.975	9.54	0.8	17	120	24	0.70	
	OFFICE SPACE	98	0.49	5	0.06	2.45	5.88	0.8	10	220	44	0.24	
	STORAGE ROOMS	250	0.5	5	0.06	2.5	15	0.8	22	190	38	0.58	
	STORAGE ROOMS	273	0.546	5	0.06	2.73	16.38	0.8	24	200	40	0.60	
	TOTALS:	3,206	60.923							3,870	960		
	SYSTEM POPULATION (P _s)										50		
	DIVERSITY (D)										0.8		
	UNCORRECTED OSA (V _{ou})										599		
	MAX Z _p										1.03		
	VENT EFF. (Ev)										0.30		
	MIN. OUTSIDE AIR (Vot), CFM										966		
AH-3	CONFERENCE / MEETING	299	12	5	0.06	60	17.94	0.8	97	415	100	0.97	
	JANITOR CLOSET, TRASH ROOM	53	0	0	0	0	0	0.8	0	50	10	NA	
	CORRIDORS	245	0	0	0.06	0	14.88	0.8	19	125	25	0.74	
	CORRIDORS	762	0	0	0.06	0	45.72	0.8	57	380	76	0.75	
	OFFICE SPACE	137	0.685	5	0.06	3.425	8.22	0.8	15	100	20	0.73	
	OFFICE SPACE	97	0.485	5	0.06	2.425	5.82	0.8	10	220	44	0.23	
	OFFICE SPACE	208	1.045	5	0.06	5.225	12.64	0.8	22	155	31	0.72	
	STORAGE ROOMS	75	0.15	5	0.06	0.75	4.5	0.8	7	50	10	0.66	
	STORAGE ROOMS	37	0.074	5	0.06	0.37	2.22	0.8	3	20	4	0.81	
	CORRIDORS	219	0	0	0.06	0	13.14	0.8	16	110	22	0.75	
	BREAK ROOMS-GENERAL	517	12.925	5	0.06	64.75	31.08	0.8	120	400	120	1.00	
	BREAK ROOMS-GENERAL	238	5.938	5	0.06	29.625	14.22	0.8	65	490	98	0.66	
	LECTURE CLASSROOM	441	25	7.5	0.06	187.5	26.46	0.8	267	700	270	0.99	
	TOILET - PUBLIC	104	0	0	0	0	0	0.8	0	100	20	NA	
	TOILET - PUBLIC	169	0	0	0	0	0	0.8	0	100	20	NA	
	CONFERENCE / MEETING	166	8.3	5	0.06	41.5	9.96	0.8	64	220	65	0.99	
	STORAGE ROOMS	159	0.318	5	0.06	1.59	9.54	0.8	14	120	24	0.58	
	STORAGE ROOMS	163	0.326	5	0.06	1.63	9.78	0.8	14	120	24	0.59	
	TOTALS:	4,093	67.258							3,875	983		
	SYSTEM POPULATION (P _s)										50		
DIVERSITY (D)										0.7			
UNCORRECTED OSA (V _{ou})										522			
MAX Z _p										1.00			
VENT EFF. (Ev)										0.30			
MIN. OUTSIDE AIR (Vot), CFM										623			

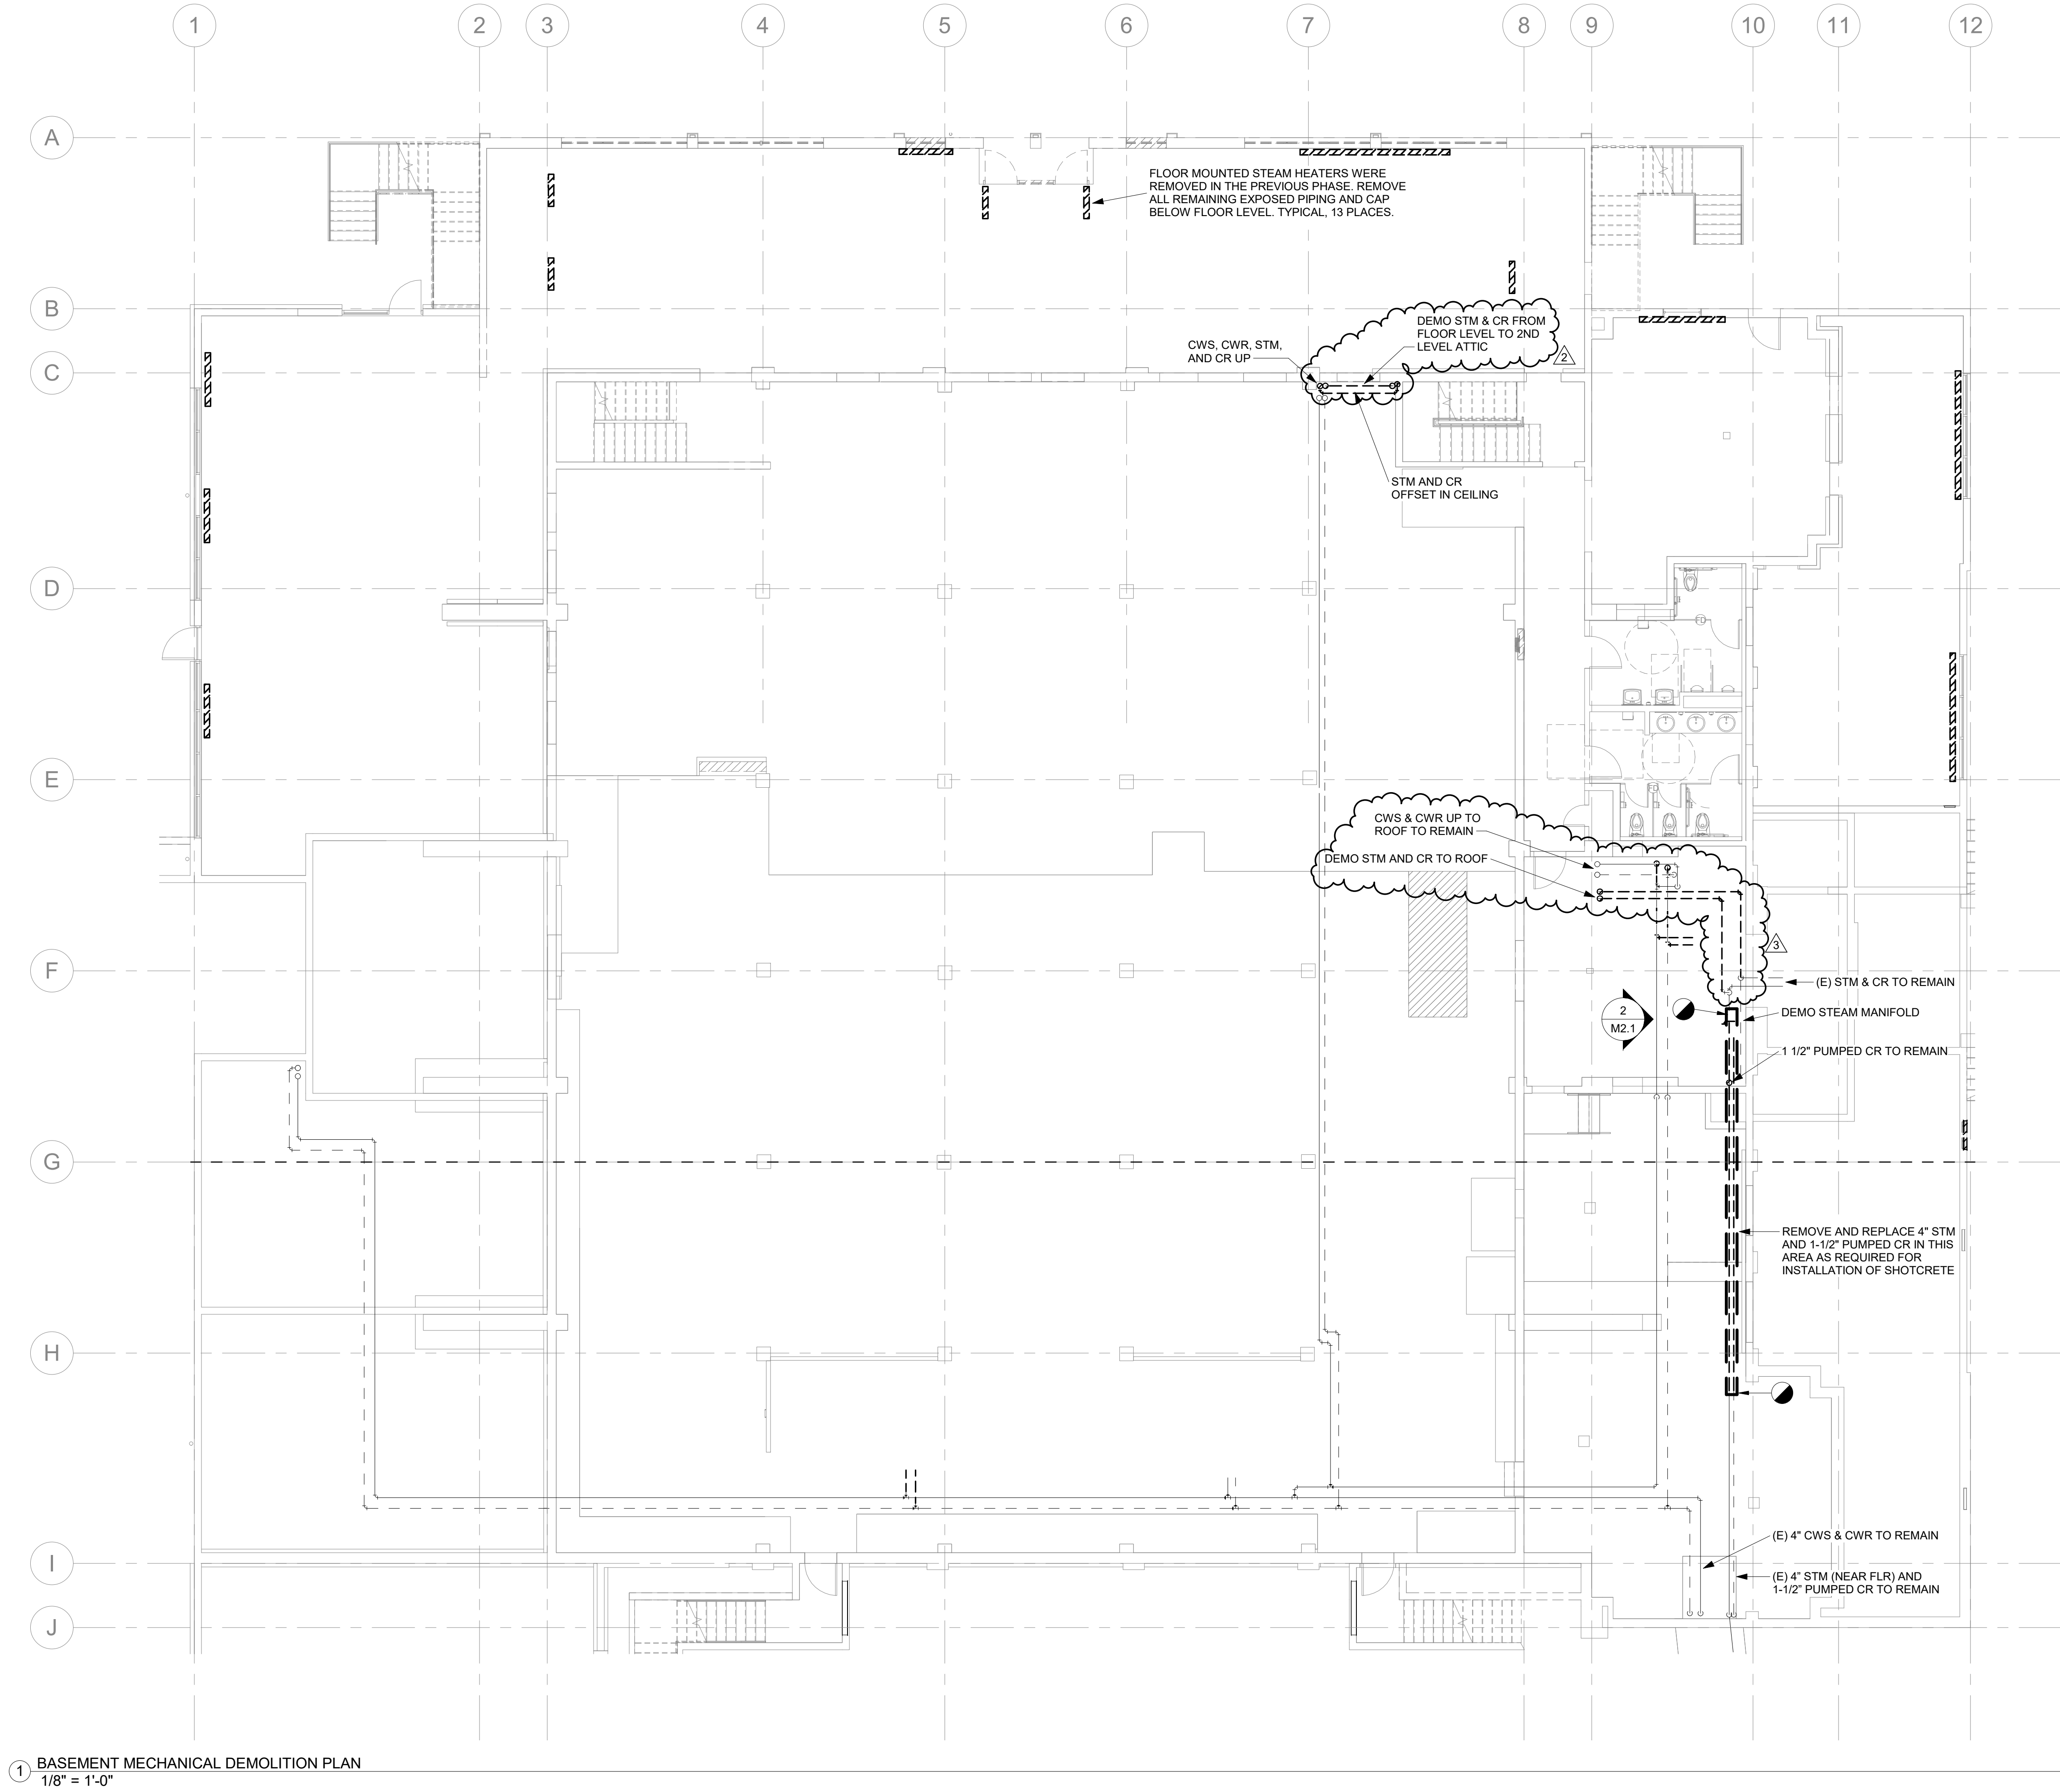

1 BASEMENT MECHANICAL DEMOLITION PLAN
1/8" = 1'-0"

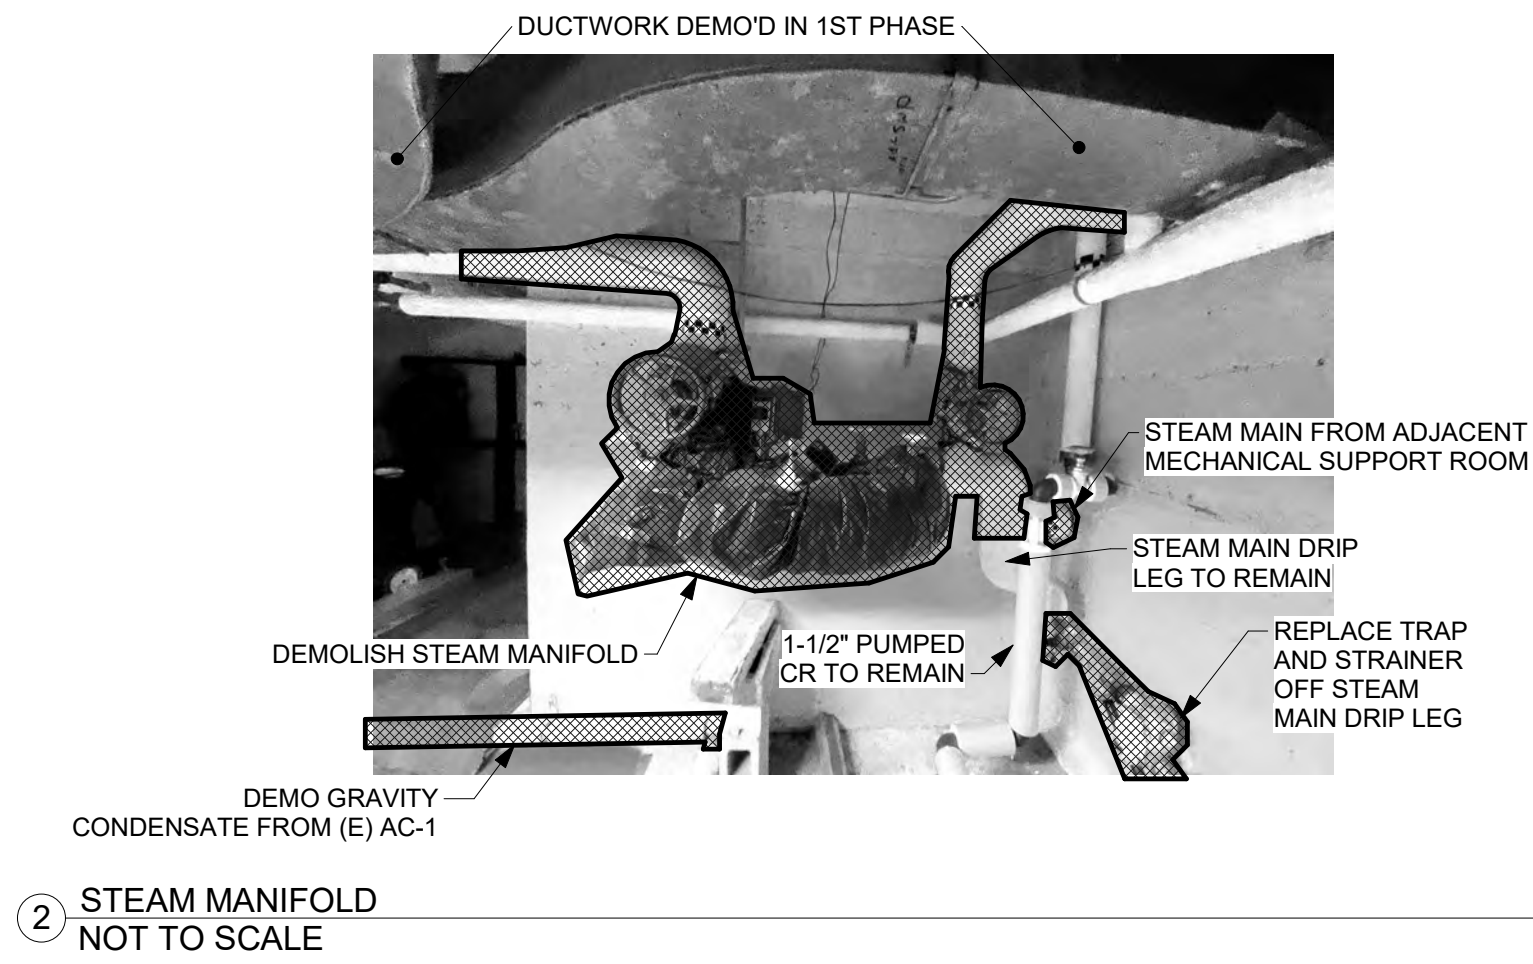

2 STEAM MANIFOLD
NOT TO SCALE

SHEET NOTES

A.

EXISTING INTERIOR PIPING, EQUIPMENT, AND DUCTWORK HAS BEEN LOCATED IN AN APPROXIMATE WAY ONLY. FIELD VERIFY LOCATION AND SIZE OF ALL EXISTING DUCTWORK, PIPING AND EQUIPMENT.

B.

ABBREVIATIONS:
STM STEAM
CR STEAM CONDENSATE RETURN
CWS CHILLED WATER SUPPLY
CWR CHILLED WATER RETURN

POINT OF DEMOLITION. REMOVE PIPE FROM THIS POINT.

kistler+small+white

architects

66 WATER STREET
SUITE 101
ASHLAND, OR
97520
TEL.: 541.488.8200

THESE DRAWINGS SHALL BE USED FOR:
CONSTRUCTION
BIDDING
RECORDATION
CONVEYANCE
ISSUANCE OF A PERMIT

PHASE 2
BID SET

REGISTERED PROFESSIONAL
ENGINEER
75561
JOHN M. KELLER
EXPIRES: 06/30/21

ArcSine engineering

A full-spectrum engineering company
950 Executive Way | Redding, CA 96002 | (530)222-7294
1236 Disk Drive | Medford, OR 97501 | (541)942-4188
www.arcsine.com


BRITT HALL - RENOVATION
SEISMIC UPGRADE / OHSU RENOVATION - PHASE 2
SOUTHERN OREGON UNIVERSITY
SISKIYOU BOULEVARD, ASHLAND OREGON, 97520

REVISIONS
2 IB-1 07.24.2020
3 IB-2 07.24.2020

BASEMENT
MECHANICAL
DEMOLITION PLAN

PROJECT NO.: 1905
ISSUE DATE: 02.13.2020
SHEET:

M2.1

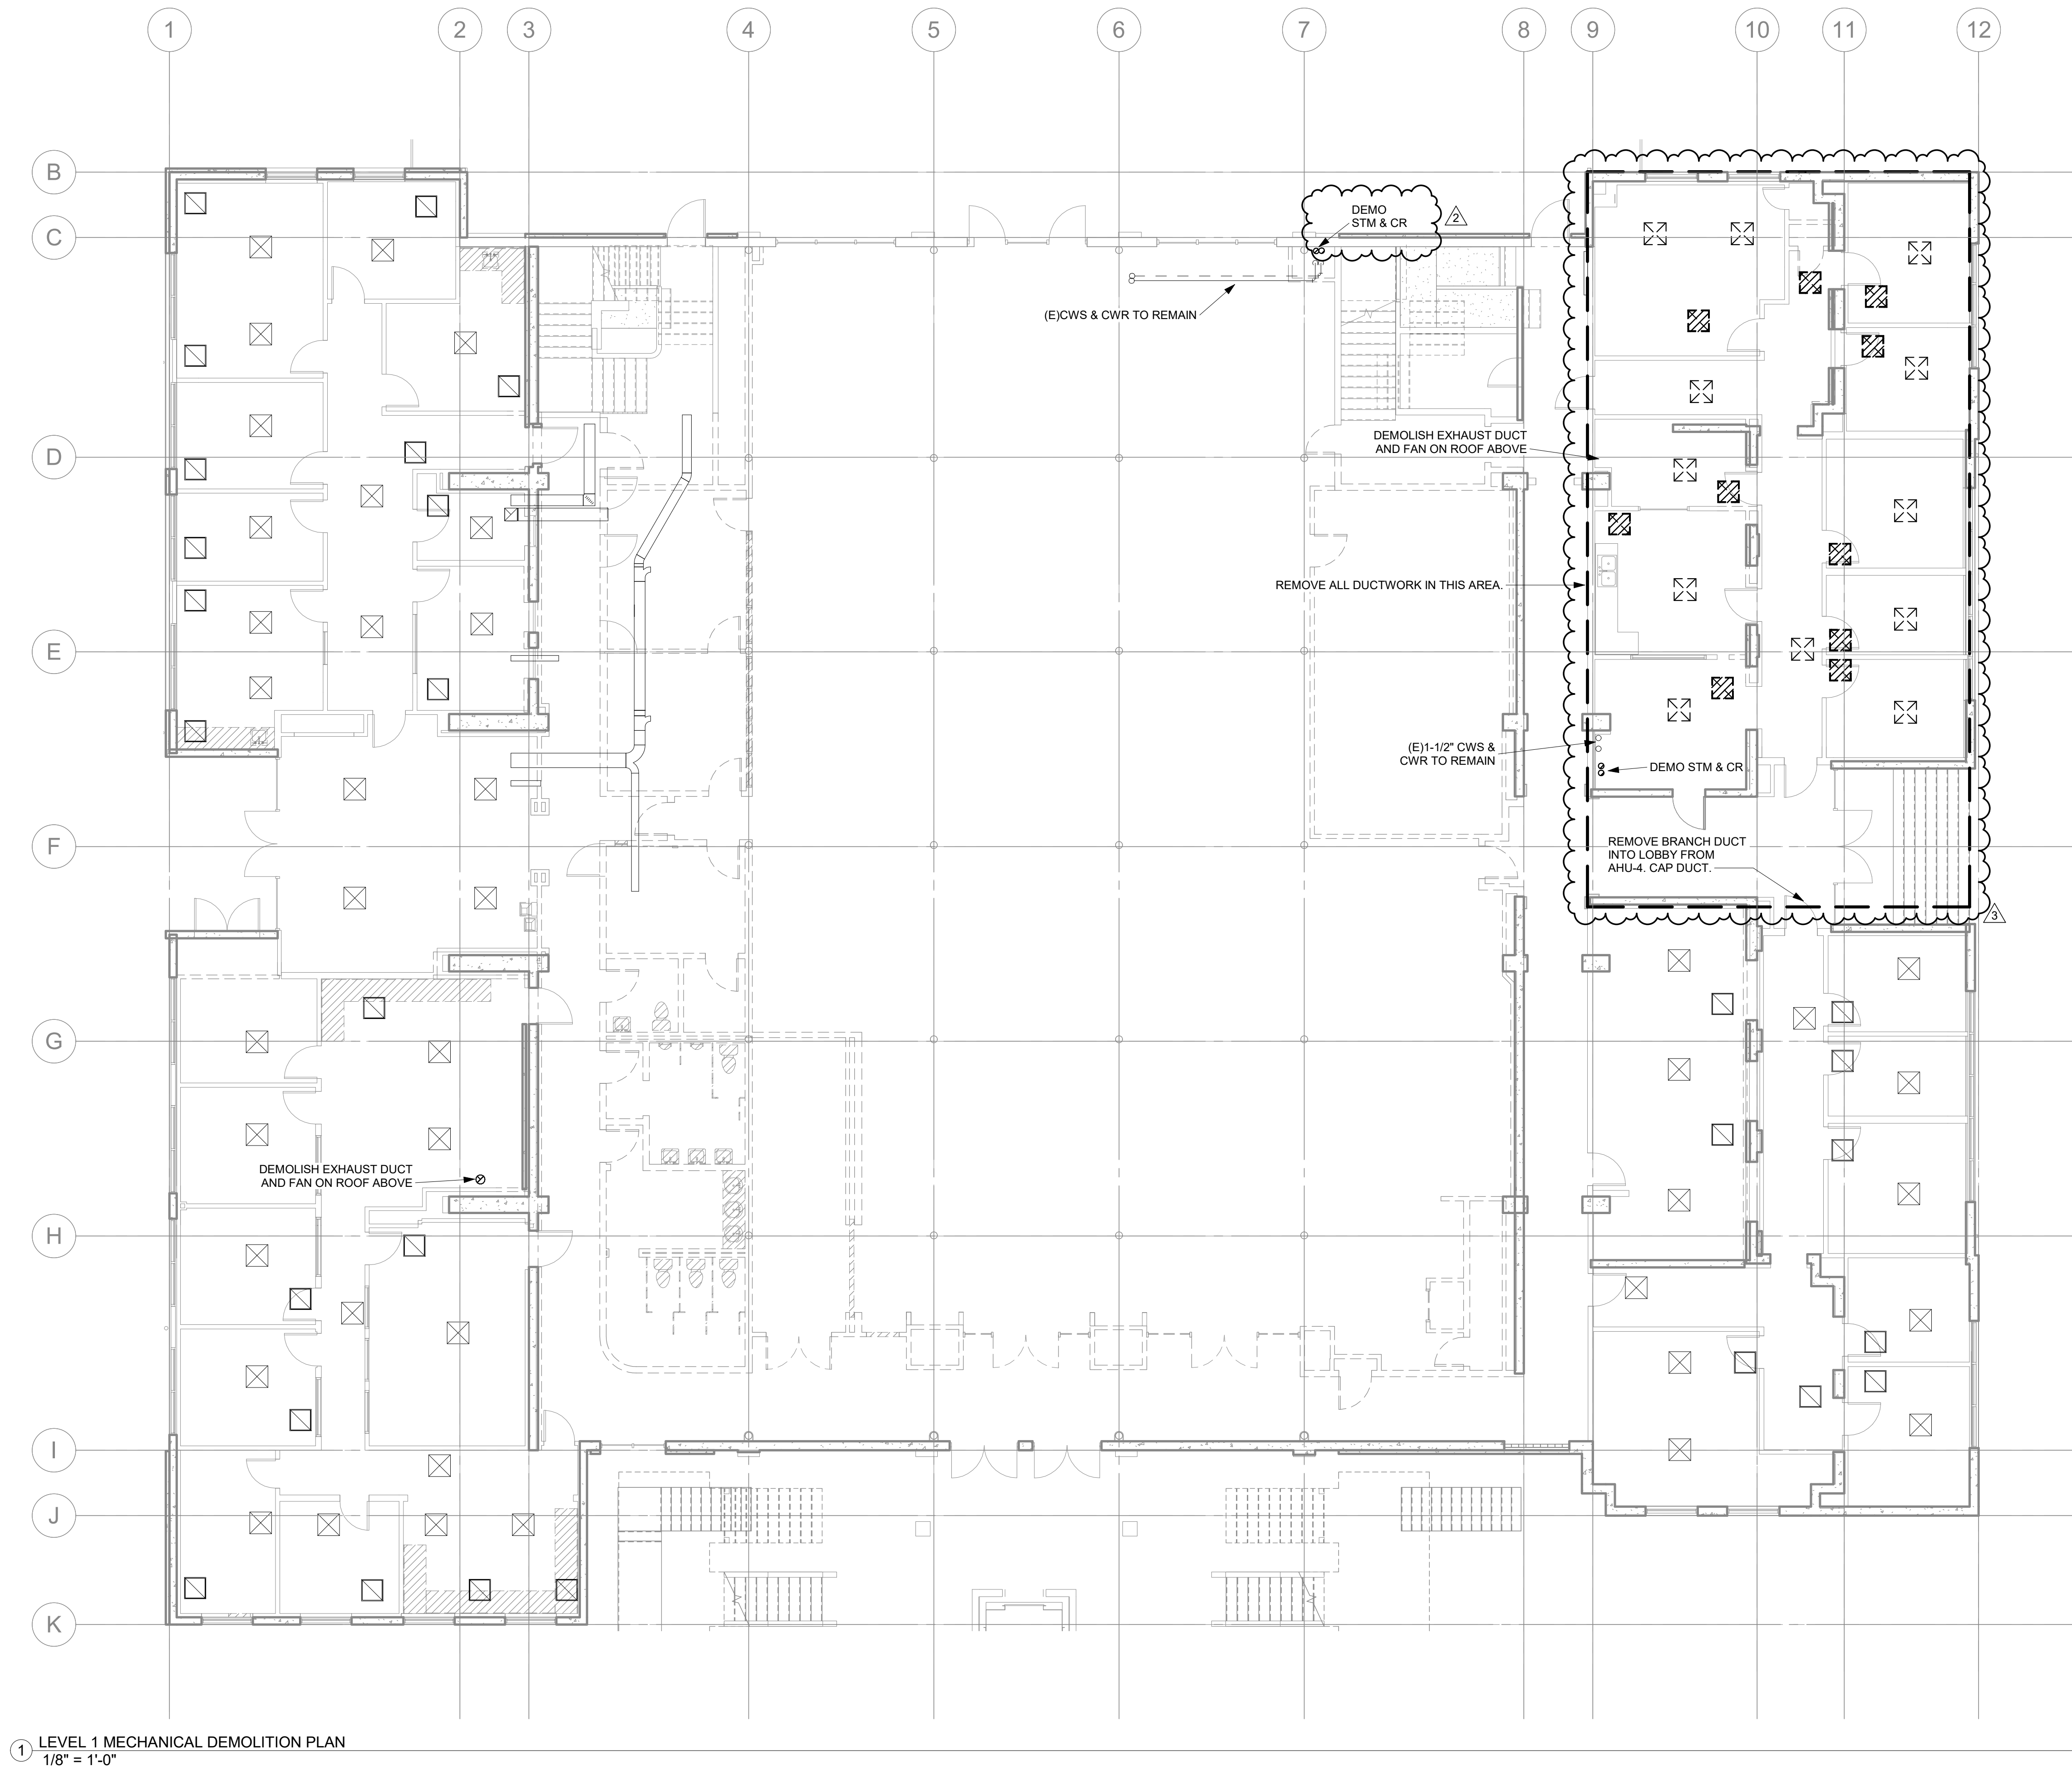

SHEET NOTES

A.

EXISTING INTERIOR PIPING, EQUIPMENT, AND DUCTWORK HAS BEEN LOCATED IN AN APPROXIMATE WAY ONLY. FIELD VERIFY LOCATION AND SIZE OF ALL EXISTING DUCTWORK, PIPING AND EQUIPMENT.

B.

ABBREVIATIONS:
STM STEAM
CR STEAM CONDENSATE RETURN
CWS CHILLED WATER SUPPLY
CWR CHILLED WATER RETURN

POINT OF DEMOLITION. REMOVE PIPE OR DUCT FROM THIS POINT.

kistler+small+white

architects

66 WATER STREET
SUITE 101
ASHLAND, OR
97520
TEL.: 541.488.8200

THESE DRAWINGS SHALL
BE USED FOR:
CONSTRUCTION
BIDDING
RECORDATION
CONVEYANCE
ISSUANCE OF A PERMIT

PHASE 2
BID SET

REGISTERED PROFESSIONAL
ENGINEER
75561
JOHN M. KELLER

EXPIRES: 06/30/21

ArcSine engineering

A full-spectrum engineering company

950 Executive Way | Redding, CA 96002 | (530)222-7294
1236 Oak Drive | Medford, OR 97501 | (541)942-4188
www.arcsine.com

BRITT HALL - RENOVATION
SEISMIC UPGRADE / OHSU RENOVATION - PHASE 2
SOUTHERN OREGON UNIVERSITY
SISKIYOU BOULEVARD, ASHLAND OREGON, 97520

REVISIONS

2

IB-1

07.24.2020

3


IB-2

07.24.2020

LEVEL 1
MECHANICAL
DEMOLITION PLAN

PROJECT NO.: 1905
ISSUE DATE: 02.13.2020
SHEET:

M2.2

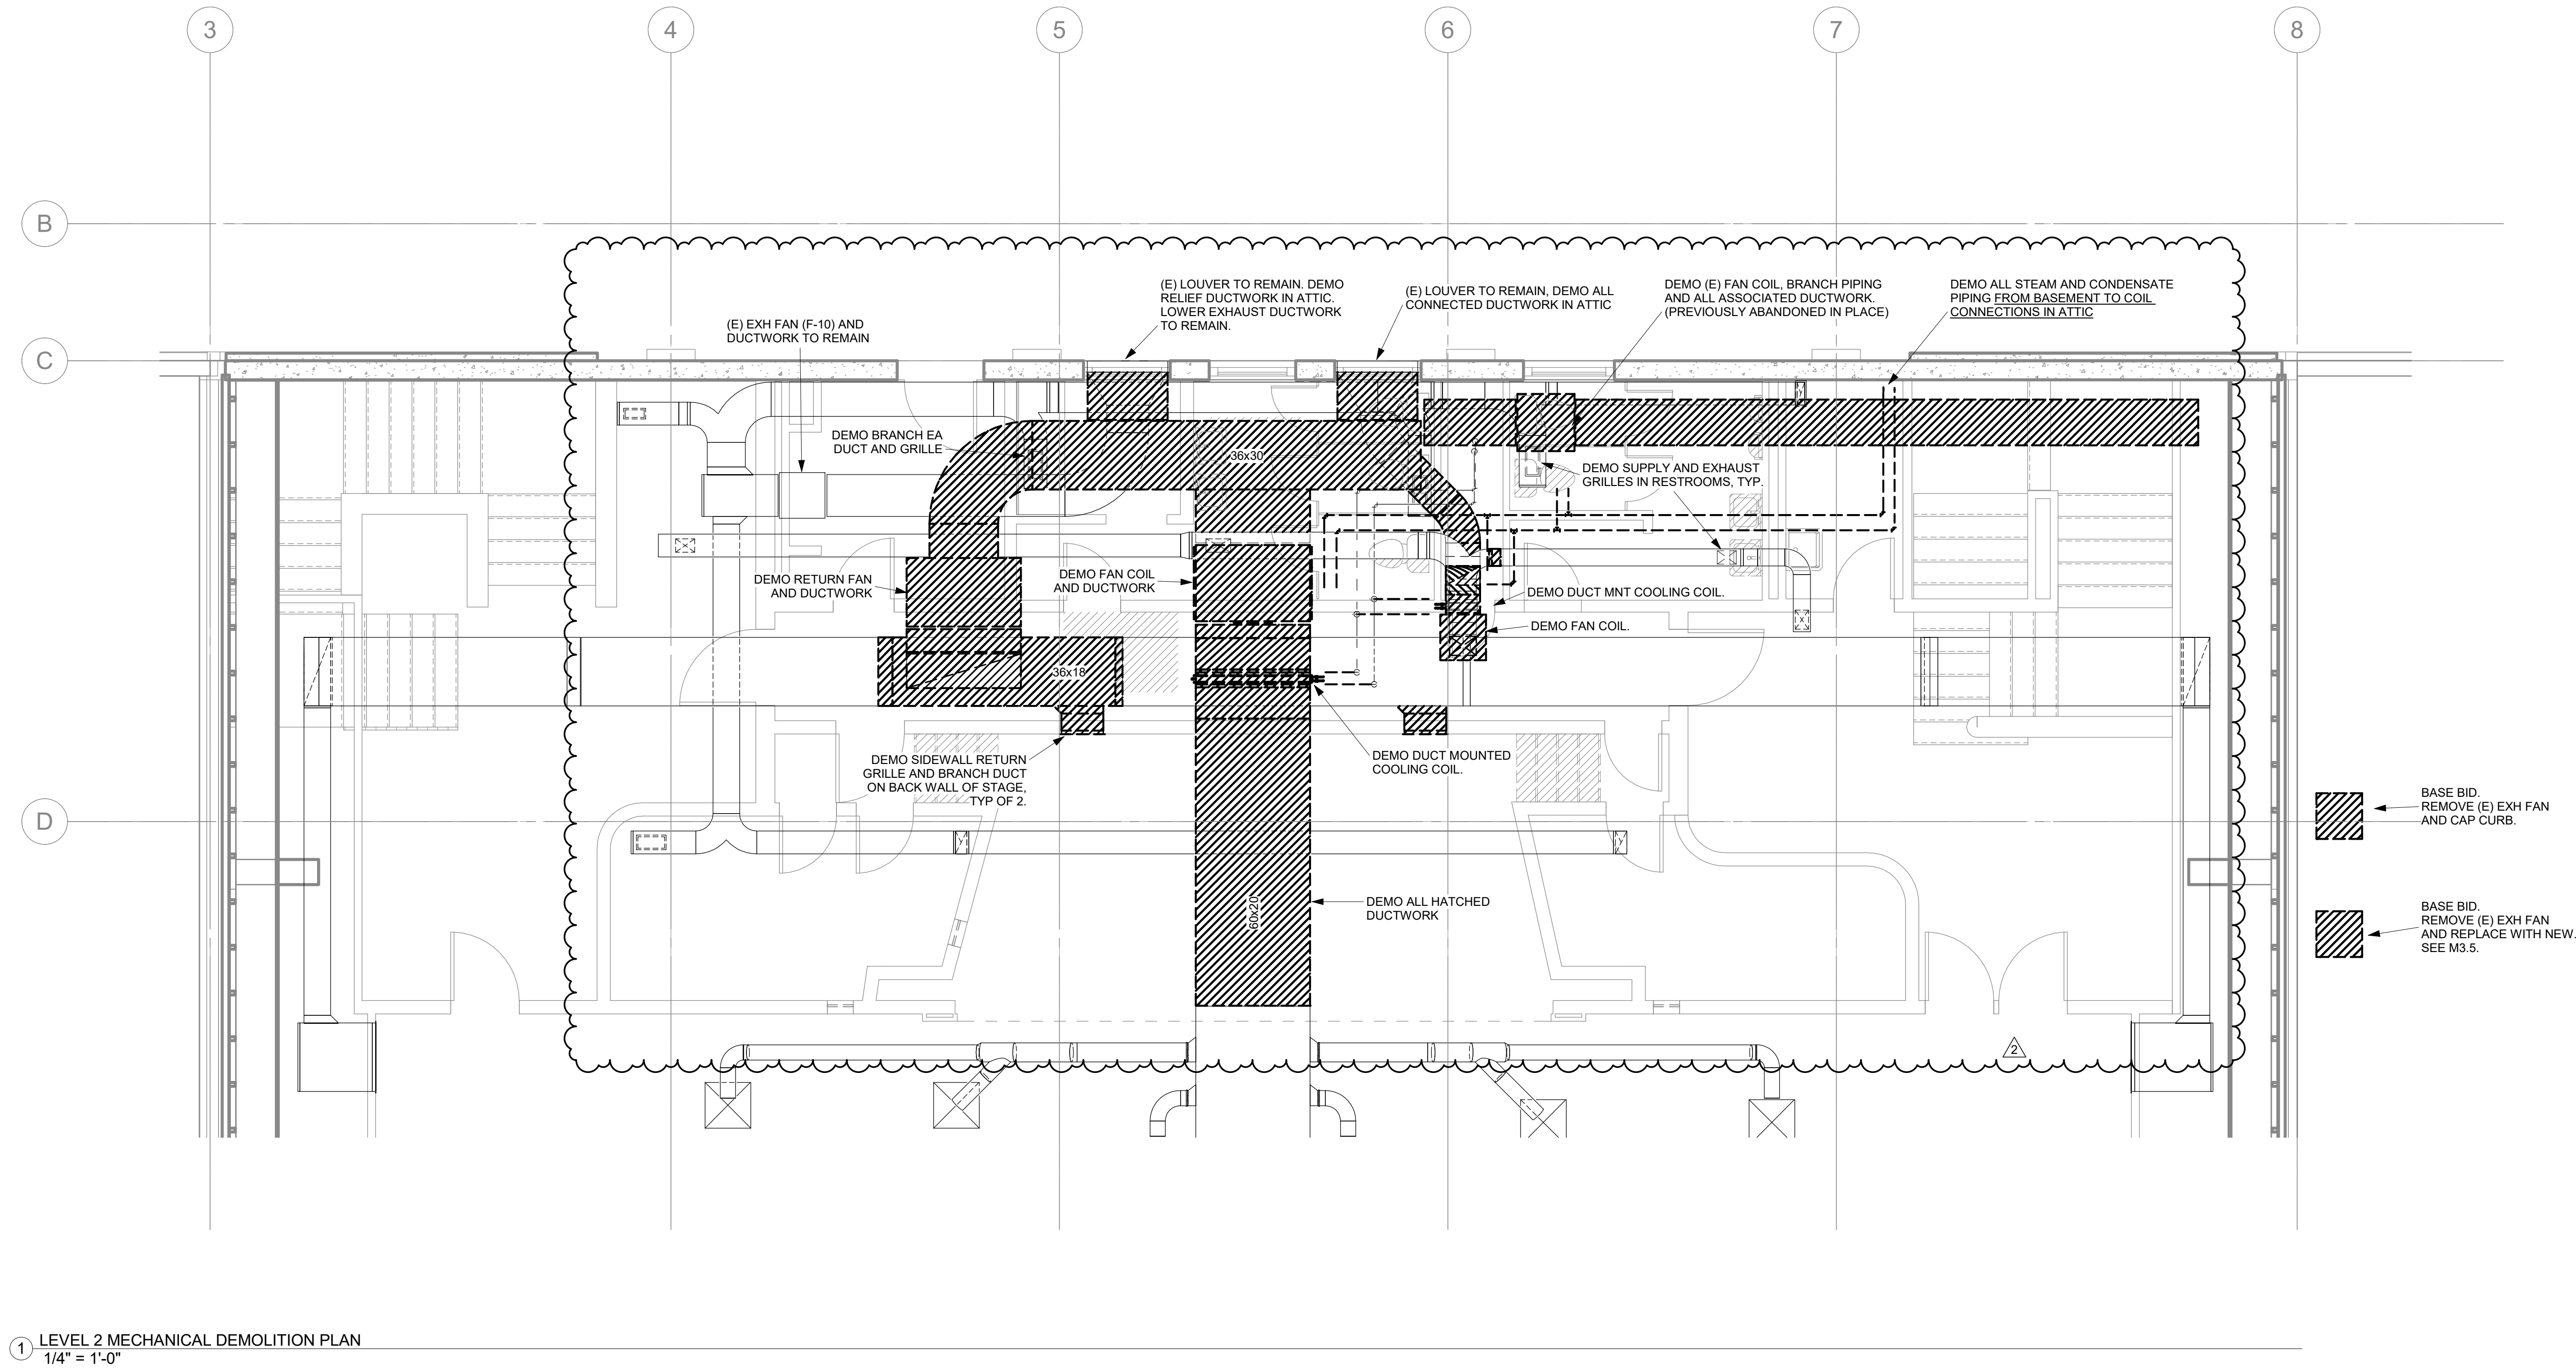

SHEET NOTES

A.

FIELD VERIFY SIZE AND LOCATION OF ALL EXISTING DUCTWORK, PIPING AND EQUIPMENT.

B.

DEMOLISH ALL HATCHED DUCTWORK AND EQUIPMENT. SEE SHEET M3.5 FOR NEW WORK.

kistler + small + white

architects

66 WATER STREET
SUITE 101
ASHLAND, OR
97520
TEL.: 541.488.8200

THESE DRAWINGS SHALL
BE USED FOR:
CONSTRUCTION
BIDDING
RECORDATION
CONVEYANCE
ISSUANCE OF A PERMIT

PHASE 2
BID SET

REGISTERED PROFESSIONAL
ENGINEER
75561
JOHN M. KELLER
EXPIRES: 06/30/21

ArcSine engineering

A full-spectrum engineering company
950 Executive Way | Redding, CA 96002 | (530)222-7204
1236 Oak Drive | Medford, OR 97501 | (541)942-4188
www.arcsine.com



BRITT HALL - RENOVATION
SEISMIC UPGRADE / OHSU RENOVATION - PHASE 2
SOUTHERN OREGON UNIVERSITY
SISKIYOU BOULEVARD, ASHLAND OREGON, 97520

REVISIONS
2 IB-1 07.24.2020

LEVEL 2
MECHANICAL
DEMOLITION PLAN

PROJECT NO.: 1905
ISSUE DATE: 02.13.2020
SHEET:

M2.3

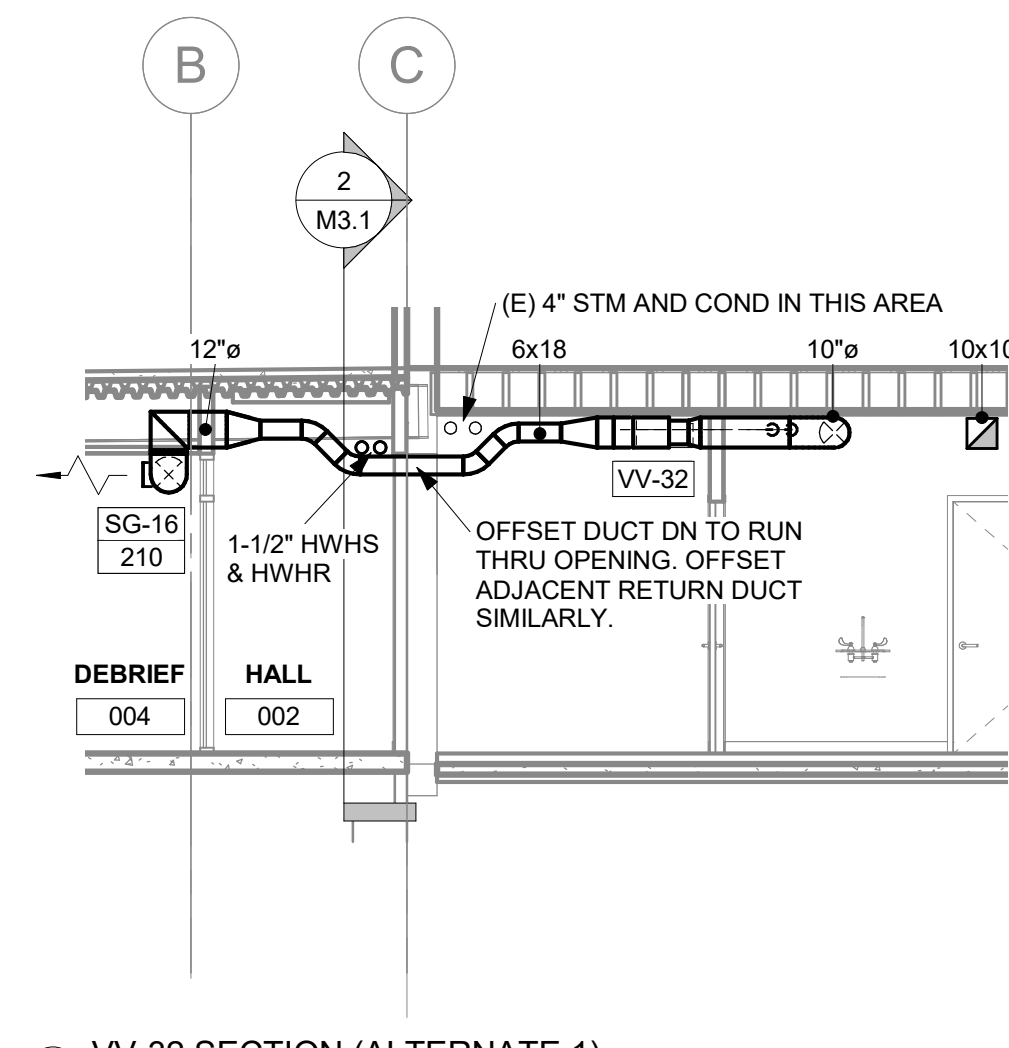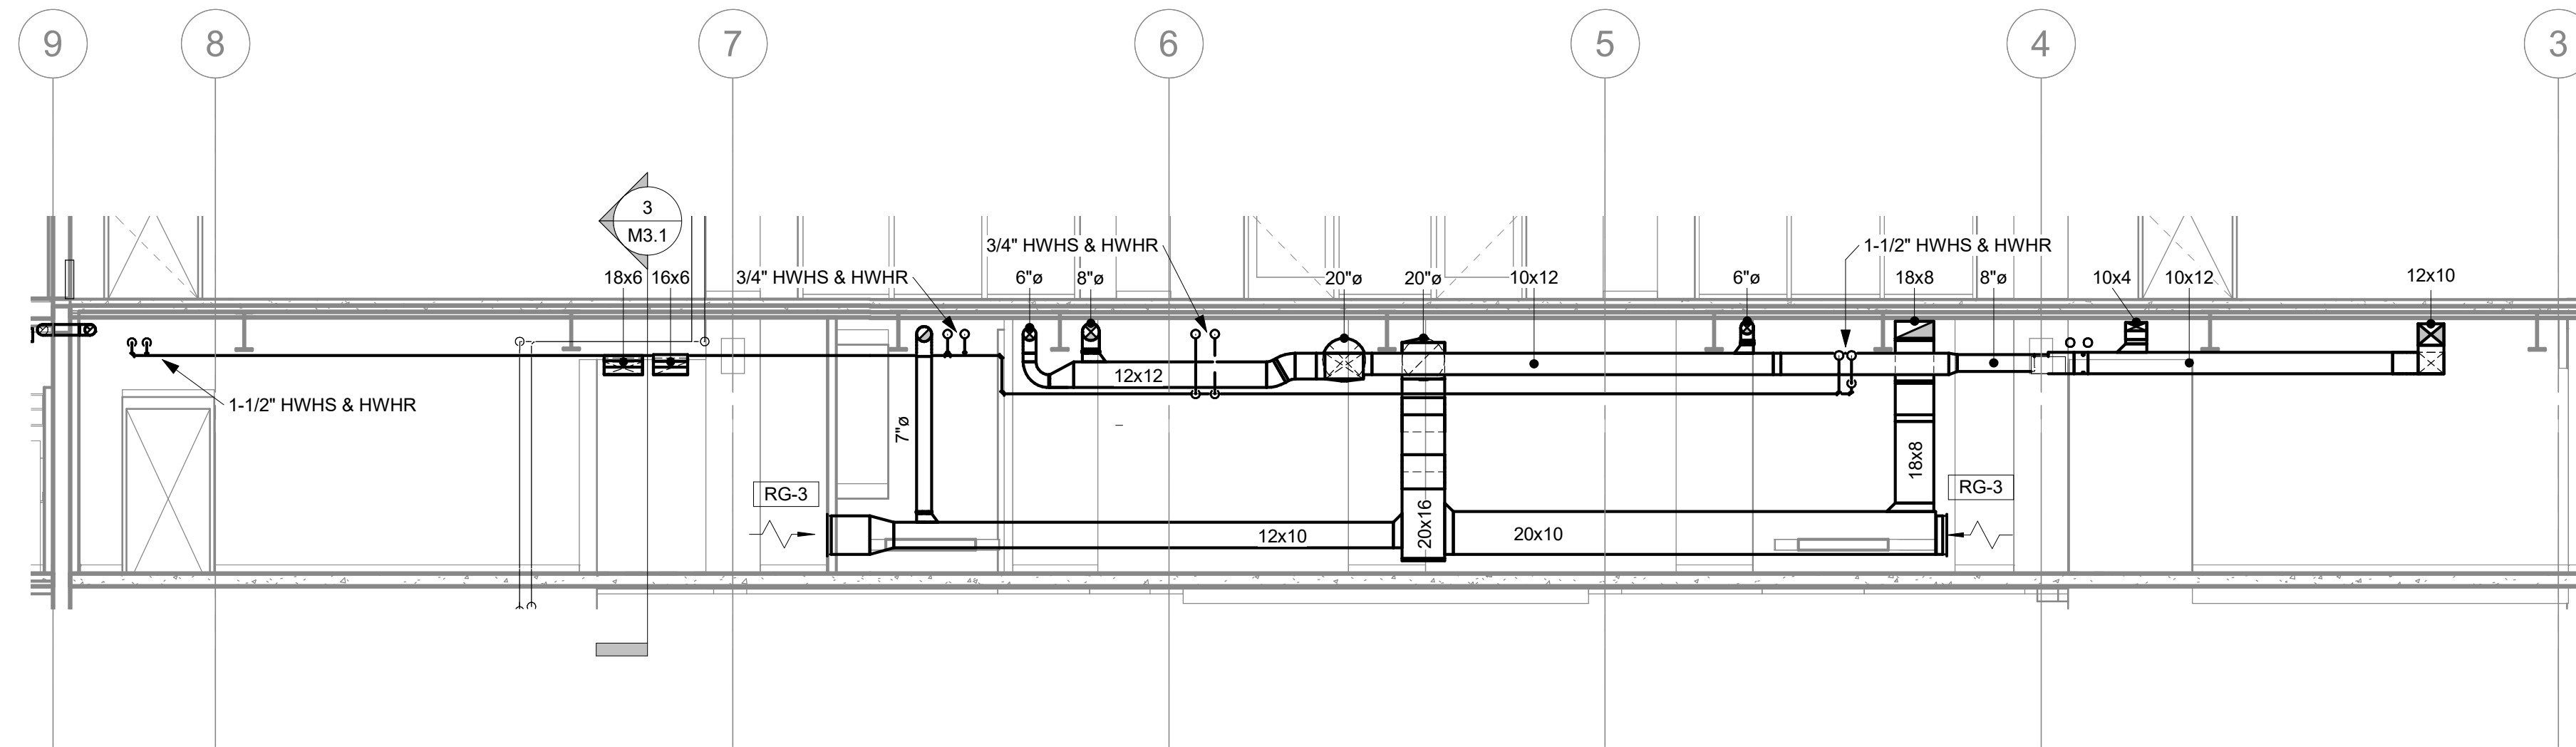


SHEET NOTES

- A. WITH THE EXCEPTION OF RESTROOMS 009 AND 010, ALL WORK ON THIS SHEET IS PART OF ALTERNATES 1, 2, OR 3. EXTEND SUPPLY DUCTS FROM RESTROOM DIFFUSERS OUT INTO HALLWAY FOR FUTURE CONNECTION.

KEYED NOTES

1. SIDEWALL DUCTLESS SPLIT SYSTEM FAN COIL. CONNECT TO CONDENSING UNIT ON LEVEL 1 ROOF. COORDINATE LOCATION WITH S.O.U.I.T. DEPARTMENT. COORDINATE INSTALL OF REFRIGERANT LINES WITH STRUCTURAL WORK ON FLOOR ABOVE.
2. EXPOSED DUCT.
3. DUCT IN SOFFIT.
4. DUCT RUNS BETWEEN WIDE FLANGE (WF) BEAMS BRANCH DUCTS TO DIFFUSERS OFF TOP OF 14x12 OVER WF BEAMS AND BETWEEN FLOOR JOISTS.
5. DUCT UP TO RUN BETWEEN FLOOR JOISTS, TYP.
6. PROVIDE 4" DRYER EXHAUST DUCT OUT THROUGH WALL TO CAP. COORDINATE LOCATION WITH ARCHITECT.
7. SUPPLY AIR GRILLE ON SIDE OF EXPOSED DUCT, TYP.
8. SUPPLY GRILLE IN SIDEWALL OF SOFFIT, TYP.
9. EXHAUST DUCT UP TO FAN ON ROOF.
10. POINT OF CONNECTION, TYP. FIELD VERIFY SIZE AND LOCATION OF EXISTING DUCT/PIPE.
11. TRANSITION TO 20x16, DROP IN EXISTING OPENING, AND OFFSET INTO CHASE. SEE 6M3.2.

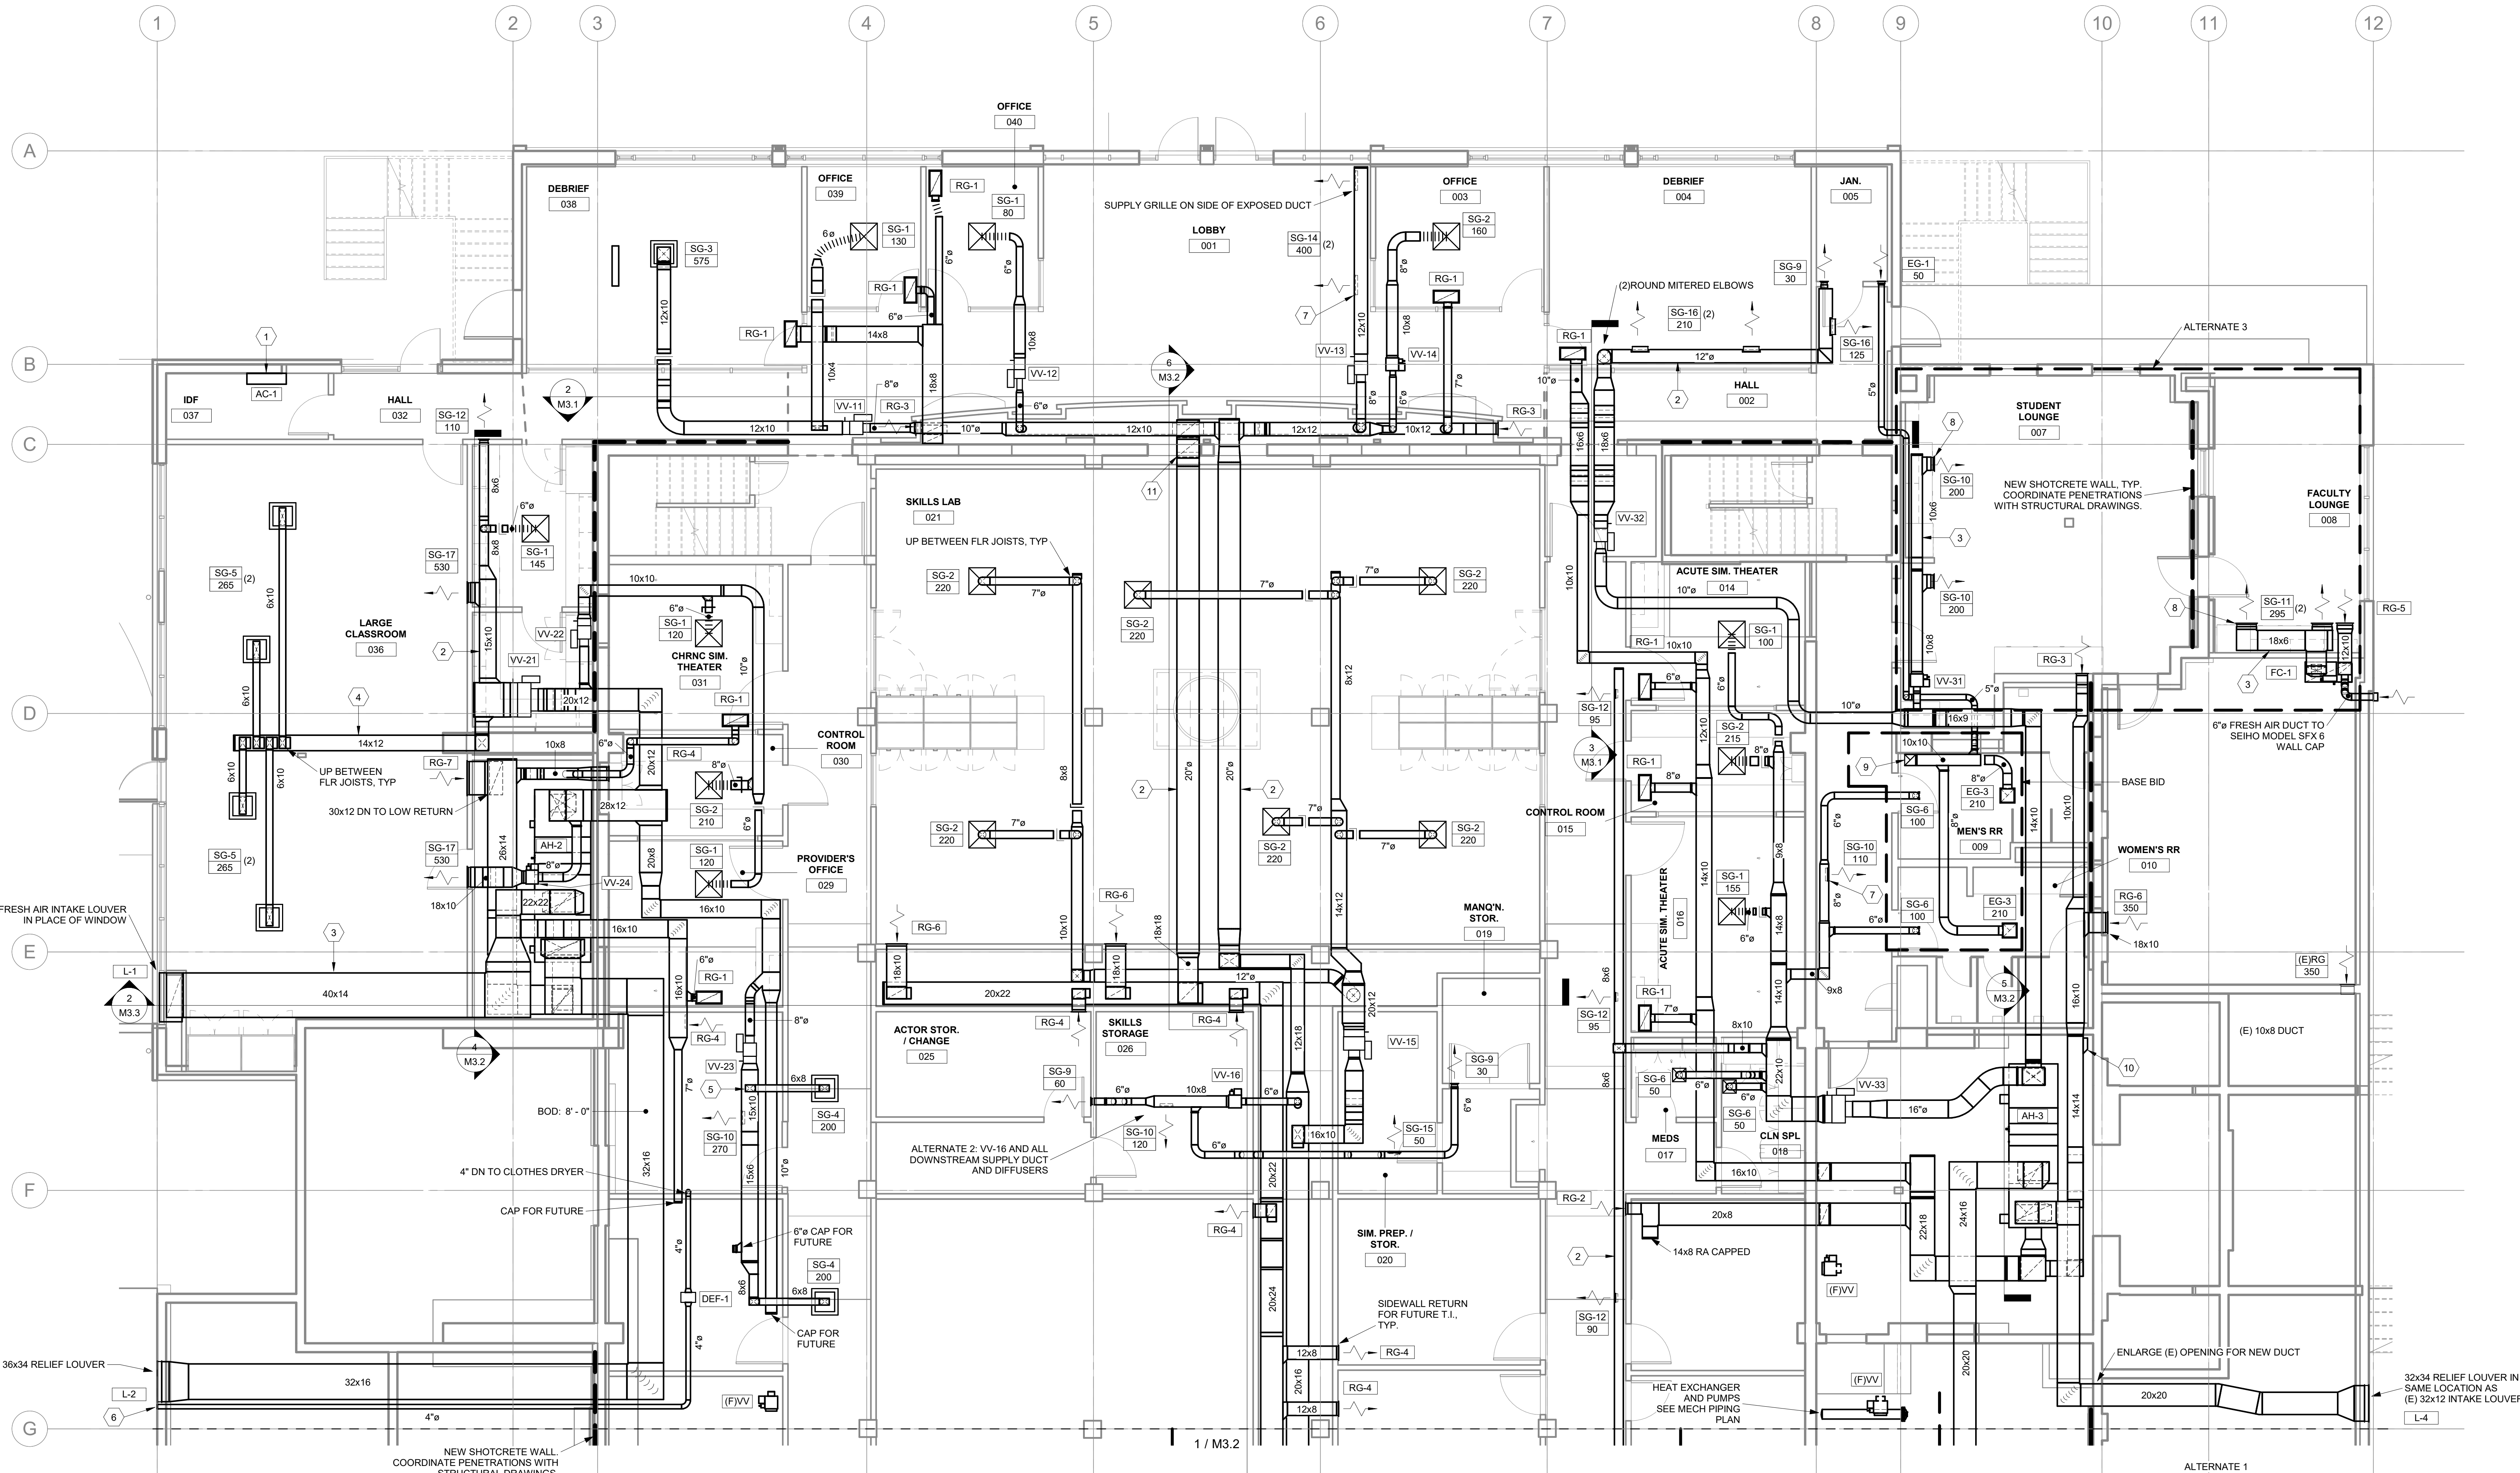


1 BASEMENT MECHANICAL PLAN - NORTH
3/16" = 1'-0"

kistler +
small
+ white
architects

66 WATER STREET
SUITE 101
ASHLAND, OR
97520
TEL.: 541.488.8200

THESE DRAWINGS SHALL
BE USED FOR:
CONSTRUCTION
BIDDING
RECORDATION
CONVEYANCE
ISSUANCE OF A PERMIT

BID SET

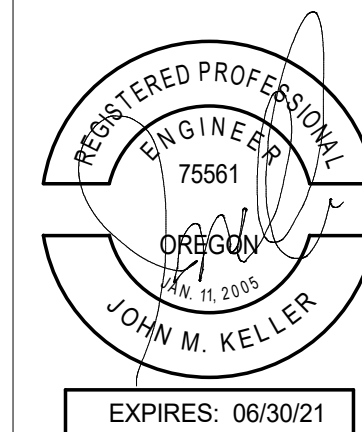

ArcSine engineering
A full-spectrum engineering company
950 Executive Way | Redding, CA 96002 | (530) 222-7204
1236 Oak Drive | Medford, OR 97501 | (541) 942-4188
www.arcsine.com




**BRITT HALL - RENOVATION
SEISMIC UPGRADE / OHSU RENOVATION - PHASE 2**
SOUTHERN OREGON UNIVERSITY
SISKIYOU BOULEVARD, ASHLAND OREGON, 97520

REVISIONS

BASEMENT
MECHANICAL PLAN -
NORTH

PROJECT NO.: 1905
ISSUE DATE: 02.13.2020
SHEET:

M3.1

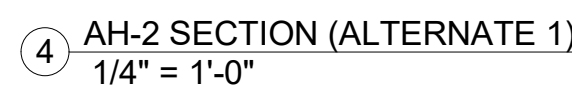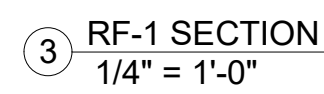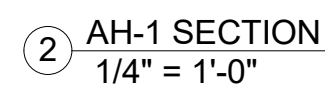


- 1 POINT OF CONNECTION, TYP. FIELD VERIFY SIZE AND LOCATION OF EXISTING DUCT/PIPE.
- 2 SUPPLY GRILLE ON END OF EXPOSED DUCT.
- 3 INSTALL MODULATING CONTROL DAMPERS IN RELIEF AIR AND RETURN AIR DUCTS




ArcSine engineering
A full-spectrum engineering company
950 Executive Way | Redding, CA 96002 | (530)222-7200
1236 Disk Drive | Medford, OR 97501 | (541)942-4188
www.arc-sine.com

BRITT HALL - RENOVATION
SEISMIC UPGRADE / OHSU RENOVATION - PHASE 2
SOUTHERN OREGON UNIVERSITY
SISKIYOU BOULEVARD, ASHLAND OREGON, 97520

M3.2

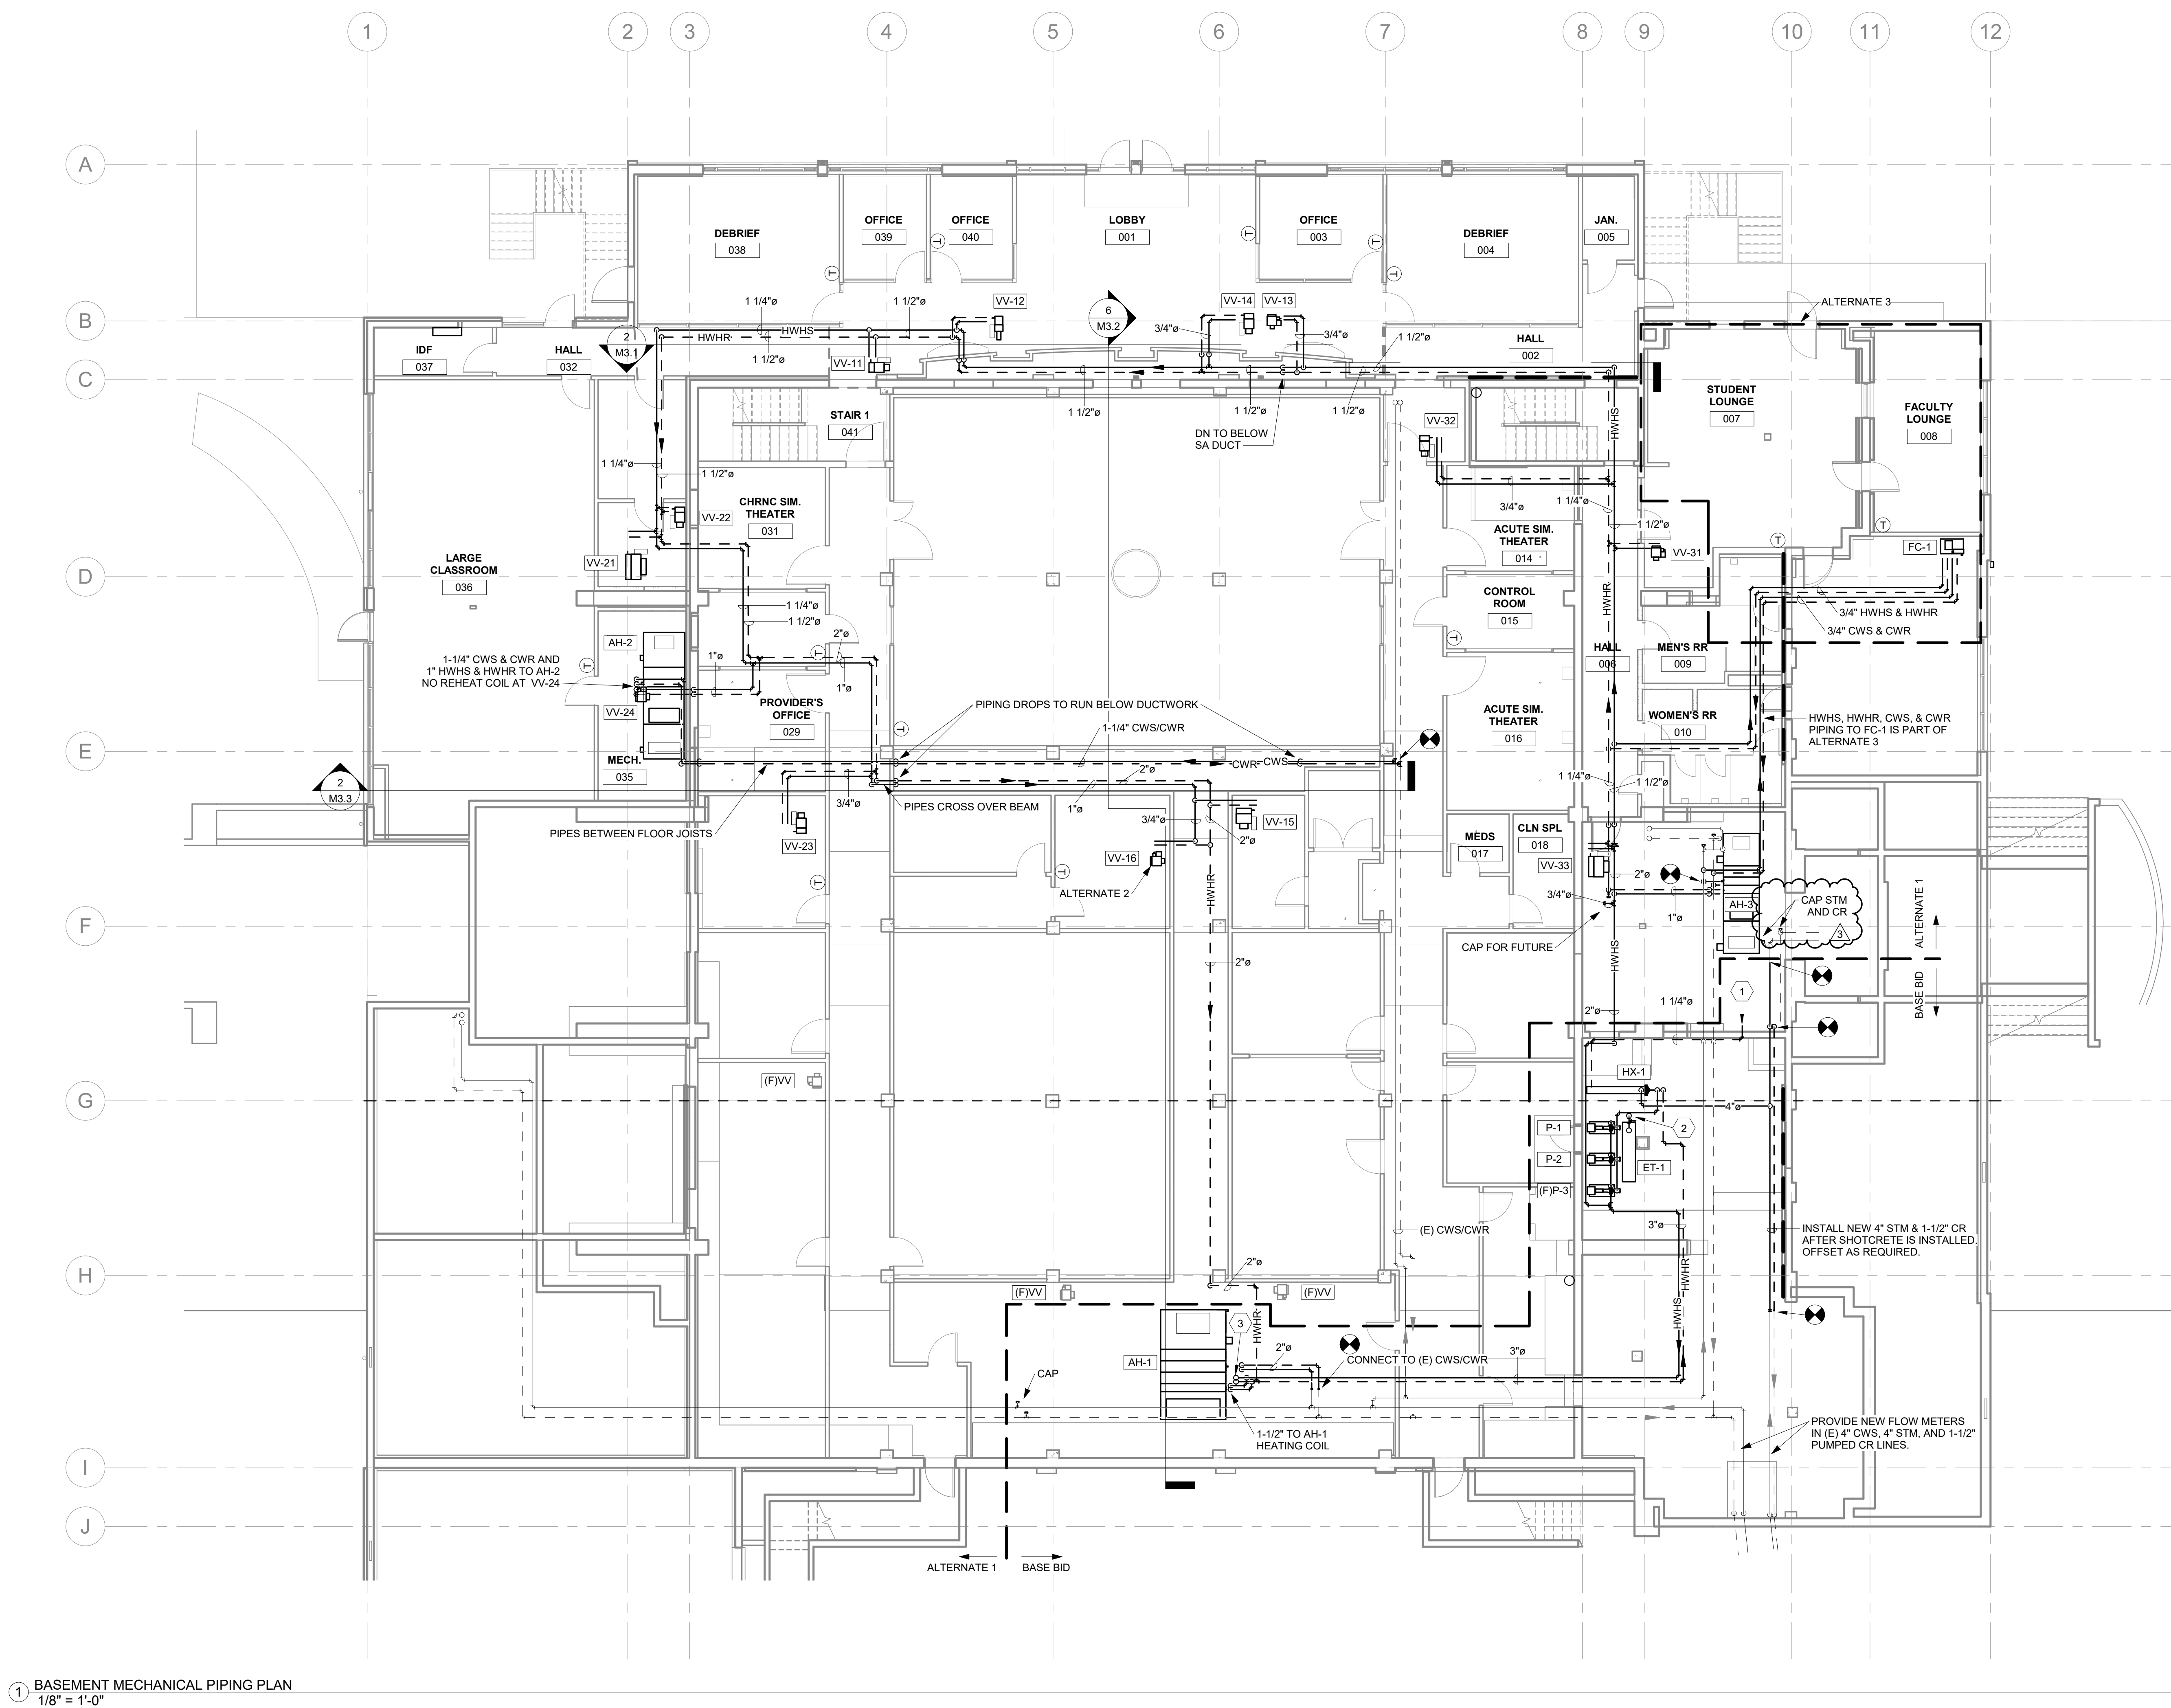

1 BASEMENT MECHANICAL PIPING PLAN
1/8" = 1'-0"

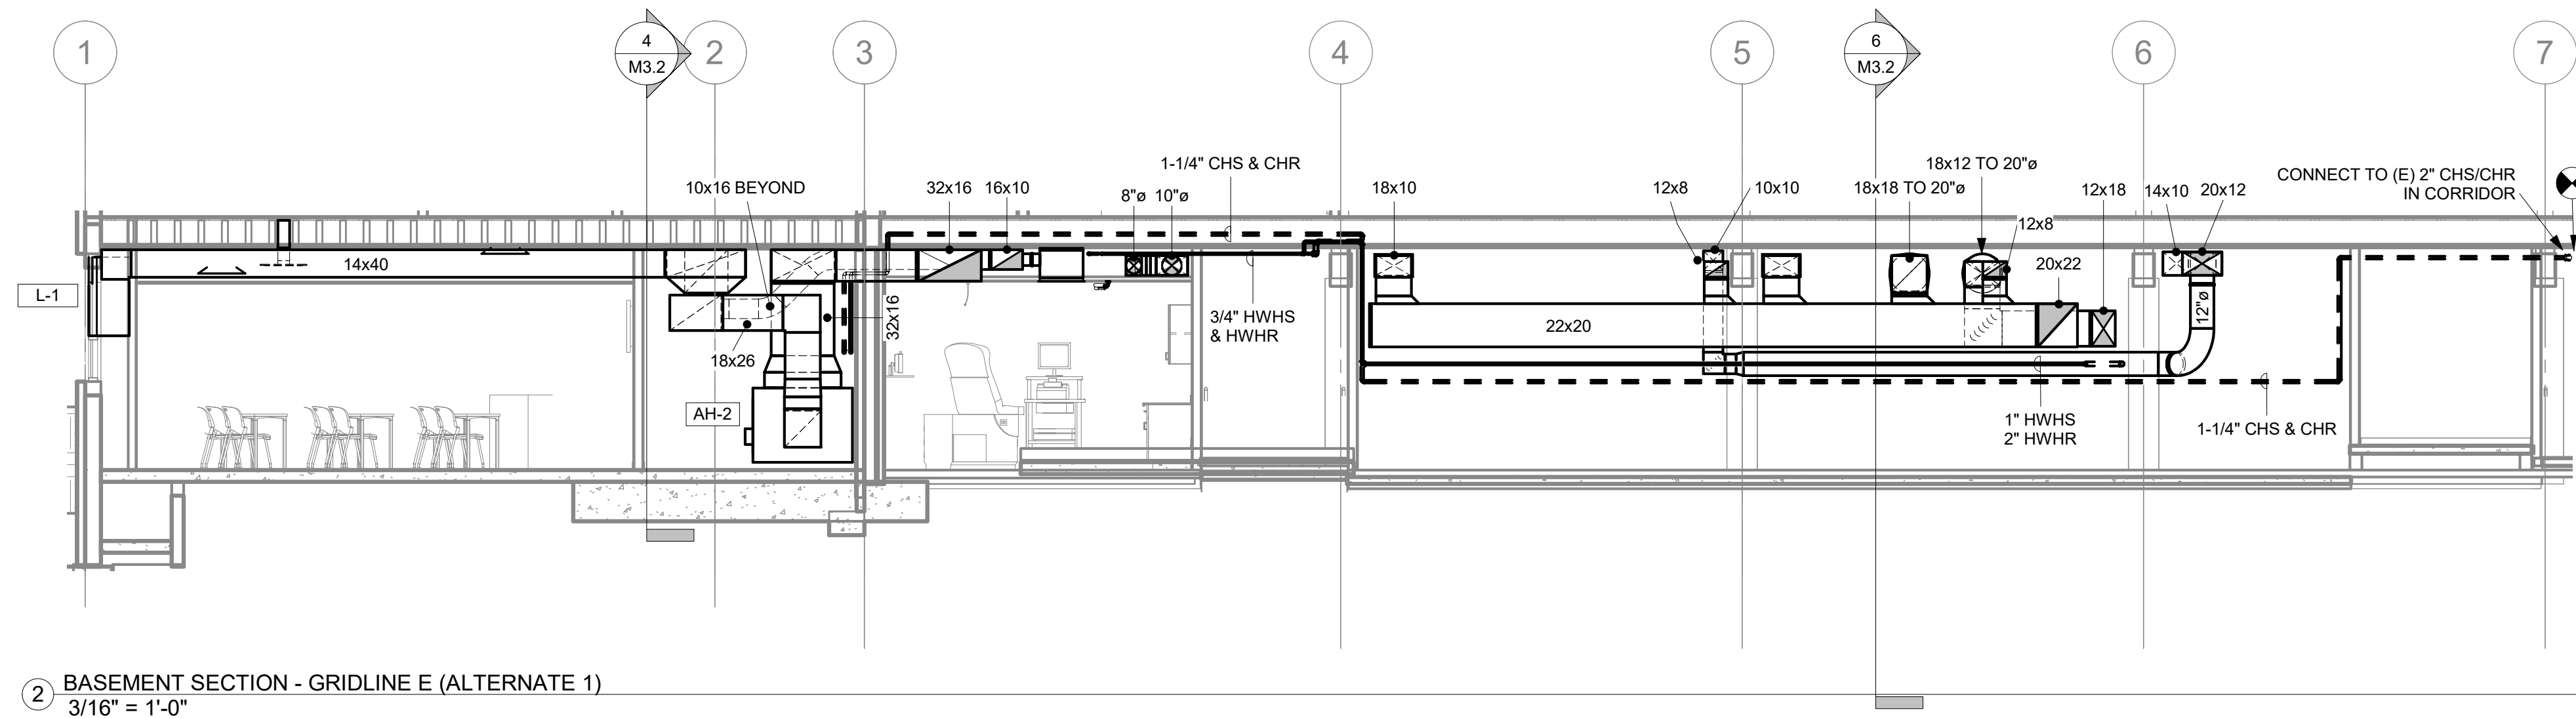

2 BASEMENT SECTION - GRIDLINE E (ALTERNATE 1)
3/16" = 1'-0"

SHEET NOTES

A.

OTHER THAN THE LOWER RIGHT HAND CORNER, ALL WORK ON THIS SHEET IS PART ALTERNATES 1, 2, OR 3.

B.

SEE PIPING SCHEMATIC ON SHEET M4.1 FOR PIPING CONNECTION DETAILS FOR HEAT EXCHANGER, PUMPS, EXPANSION TANK, AIR SEPARATOR, HEATING AND COOLING COILS, ETC.

C.

COORDINATE CONDENSATE DRAIN PIPING WITH PLUMBING CONTRACTOR.

D.

NEW STEAM, PUMPED CONDENSATE, AND CHILLED WATER FLOW METERS SHALL BE PROVIDED BY THE CONTROLS CONTRACTOR (SEE SECTION 23 09 23) AND INSTALLED BY THE MECHANICAL CONTRACTOR. INSTALL PER MANUFACTURER'S INSTRUCTIONS WITH RECOMMENDED UP AND DOWN STREAM CLEARANCES, ECCENTRIC REDUCERS, FLOW STRAIGHTENERS, ETC. AS REQUIRED. CONTRACTOR TO FIELD VERIFY EXACT LOCATIONS FOR NEW METERS.

KEYED NOTES

1

CONNECT CONDENSATE FROM HX-1 TO EXISTING BELOW GRADE CONDENSATE RETURN TANK.

2

AIR SEPARATOR IN THIS AREA. SEE EXPANSION TANK SCHEDULE FOR SIZE.

3

3" HWHS & HWHR UP IN (E) CHASE. PROVIDE ISOLATION VALVES ON PIPING RISING TO LEVEL 1. PROVIDE DRAIN DOWN VALVES WITH HOSE CONNECTIONS.

kistler + small + white

architects

66 WATER STREET
SUITE 101
ASHLAND, OR
97520
TEL.: 541.488.8200

THESE DRAWINGS SHALL
BE USED FOR:
CONSTRUCTION
BIDDING
RECORDATION
CONVEYANCE
ISSUANCE OF A PERMIT

PHASE 2
BID SET


REGISTERED PROFESSIONAL
ENGINEER
75561
JOHN M. KELLER
EXPIRES: 06/30/21

BRITT HALL - RENOVATION
SEISMIC UPGRADE / OHSU RENOVATION - PHASE 2
SOUTHERN OREGON UNIVERSITY
SISKIYOU BOULEVARD, ASHLAND OREGON, 97520

REVISIONS
3 IB-2 07.24.2020

BASEMENT
MECHANICAL
PIPING PLAN

PROJECT NO.: 1905
ISSUE DATE: 02.13.2020
SHEET:
M3.3

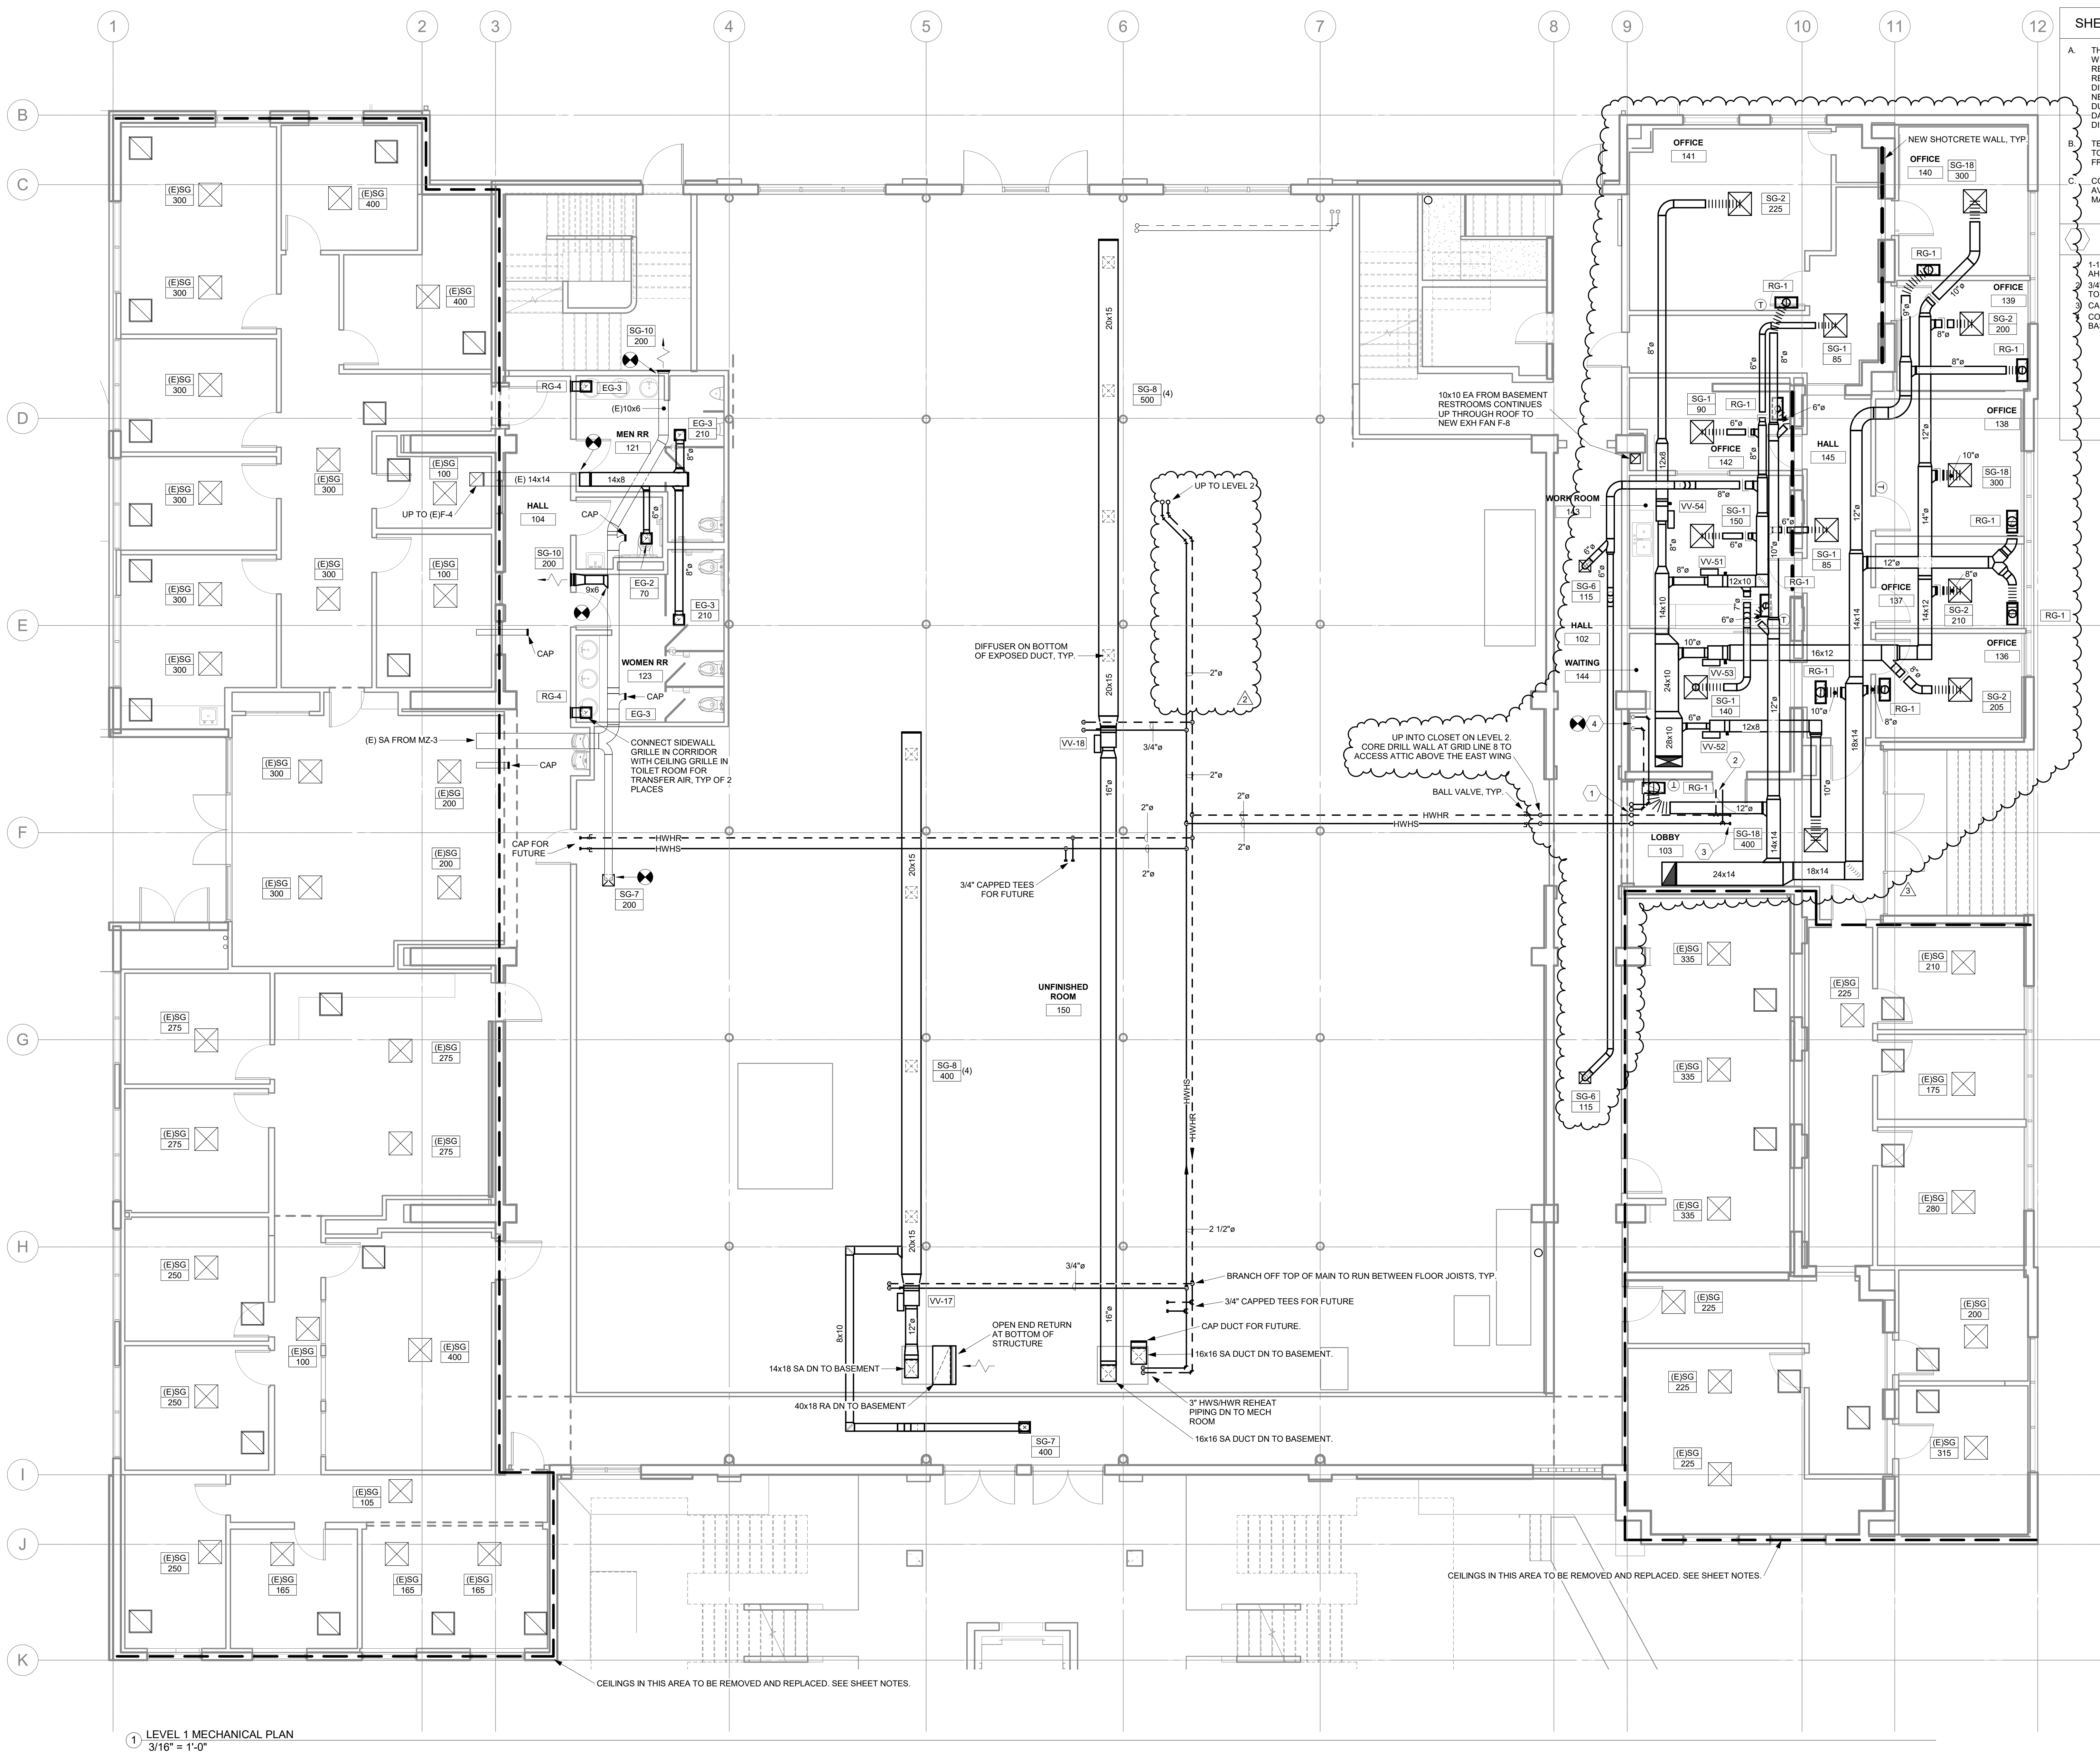

① LEVEL 1 MECHANICAL PLAN
3/16" = 1'-0"

SHEET NOTES

- A. THE CEILINGS IN THE EAST AND WEST WINGS WERE REMOVED DURING PHASE 1 AND WILL BE REPLACED IN PHASE 2. THE CONTRACTOR SHALL RE-INSTALL THE GRILLES, REGISTERS, AND DIFFUSERS (GRD) IN THE NEW CEILING. PROVIDE NEW FLEXIBLE DUCT TO CONNECT TO THE (E) DUCTWORK. PROVIDE NEW MANUAL BALANCING DAMPERS WHERE (E) DUCT MOUNTED OR DIFFUSER MOUNTED DAMPERS ARE NOT PRESENT.
- B. TEST AND BALANCE THE EXISTING HVAC SYSTEMS TO THE LISTED SUPPLY AIR VOLUMES (COPIED FROM THE EXISTING DRAWINGS).
- C. COPIES OF THE EXISTING DRAWINGS ARE AVAILABLE FROM THE SOU FACILITIES PROJECT MANAGER.

KEYED NOTES

- 1-1/4" CWS & CWR AND 3/4" HWHS & HWHR UP TO AH-5.
- 2 3/4" HWHS & HWHR TO REHEAT COILS. INSTALL 3/4" TO EACH COIL.
- 3 CAP 2" HWHS & HWHR FOR FUTURE.
- 4 CONNECT TO (E) 1-1/2" CWS & CWR RISING UP FROM BASEMENT. FIELD VERIFY LOCATION.


kistler+
small
+white

3 WATER STREET
SUITE 101
SHLAND, OR
97520
TEL.: 541.488.8200

THESE DRAWINGS SHALL
BE USED FOR:
CONSTRUCTION
BIDDING
RECORDATION
CONVEYANCE
ISSUANCE OF A PERMIT

PHASE 2

GRID SET

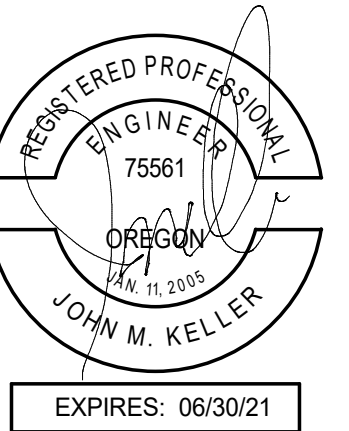

ArcSine engineering
A full-spectrum engineering company

950 Executive Way | Redding, CA 96002 | (530) 222-7200
1236 Disk Drive | Medford, OR 97501 | (541) 842-4188
www.arc-sine.com


BRITT HALL - RENOVATION
SEISMIC UPGRADE / OHSU RENOVATION - PHASE 2
SOUTHERN OREGON UNIVERSITY
SISKIYOU BOULEVARD, ASHLAND OREGON, 97520

REVISIONS	
2 IB-1	07.24.2020
3 IB-2	07.24.2020

LEVEL 1
MECHANICAL PLAN

PROJECT NO.: 1905
ISSUE DATE: 02.13.2020
SHEET:

M3.4

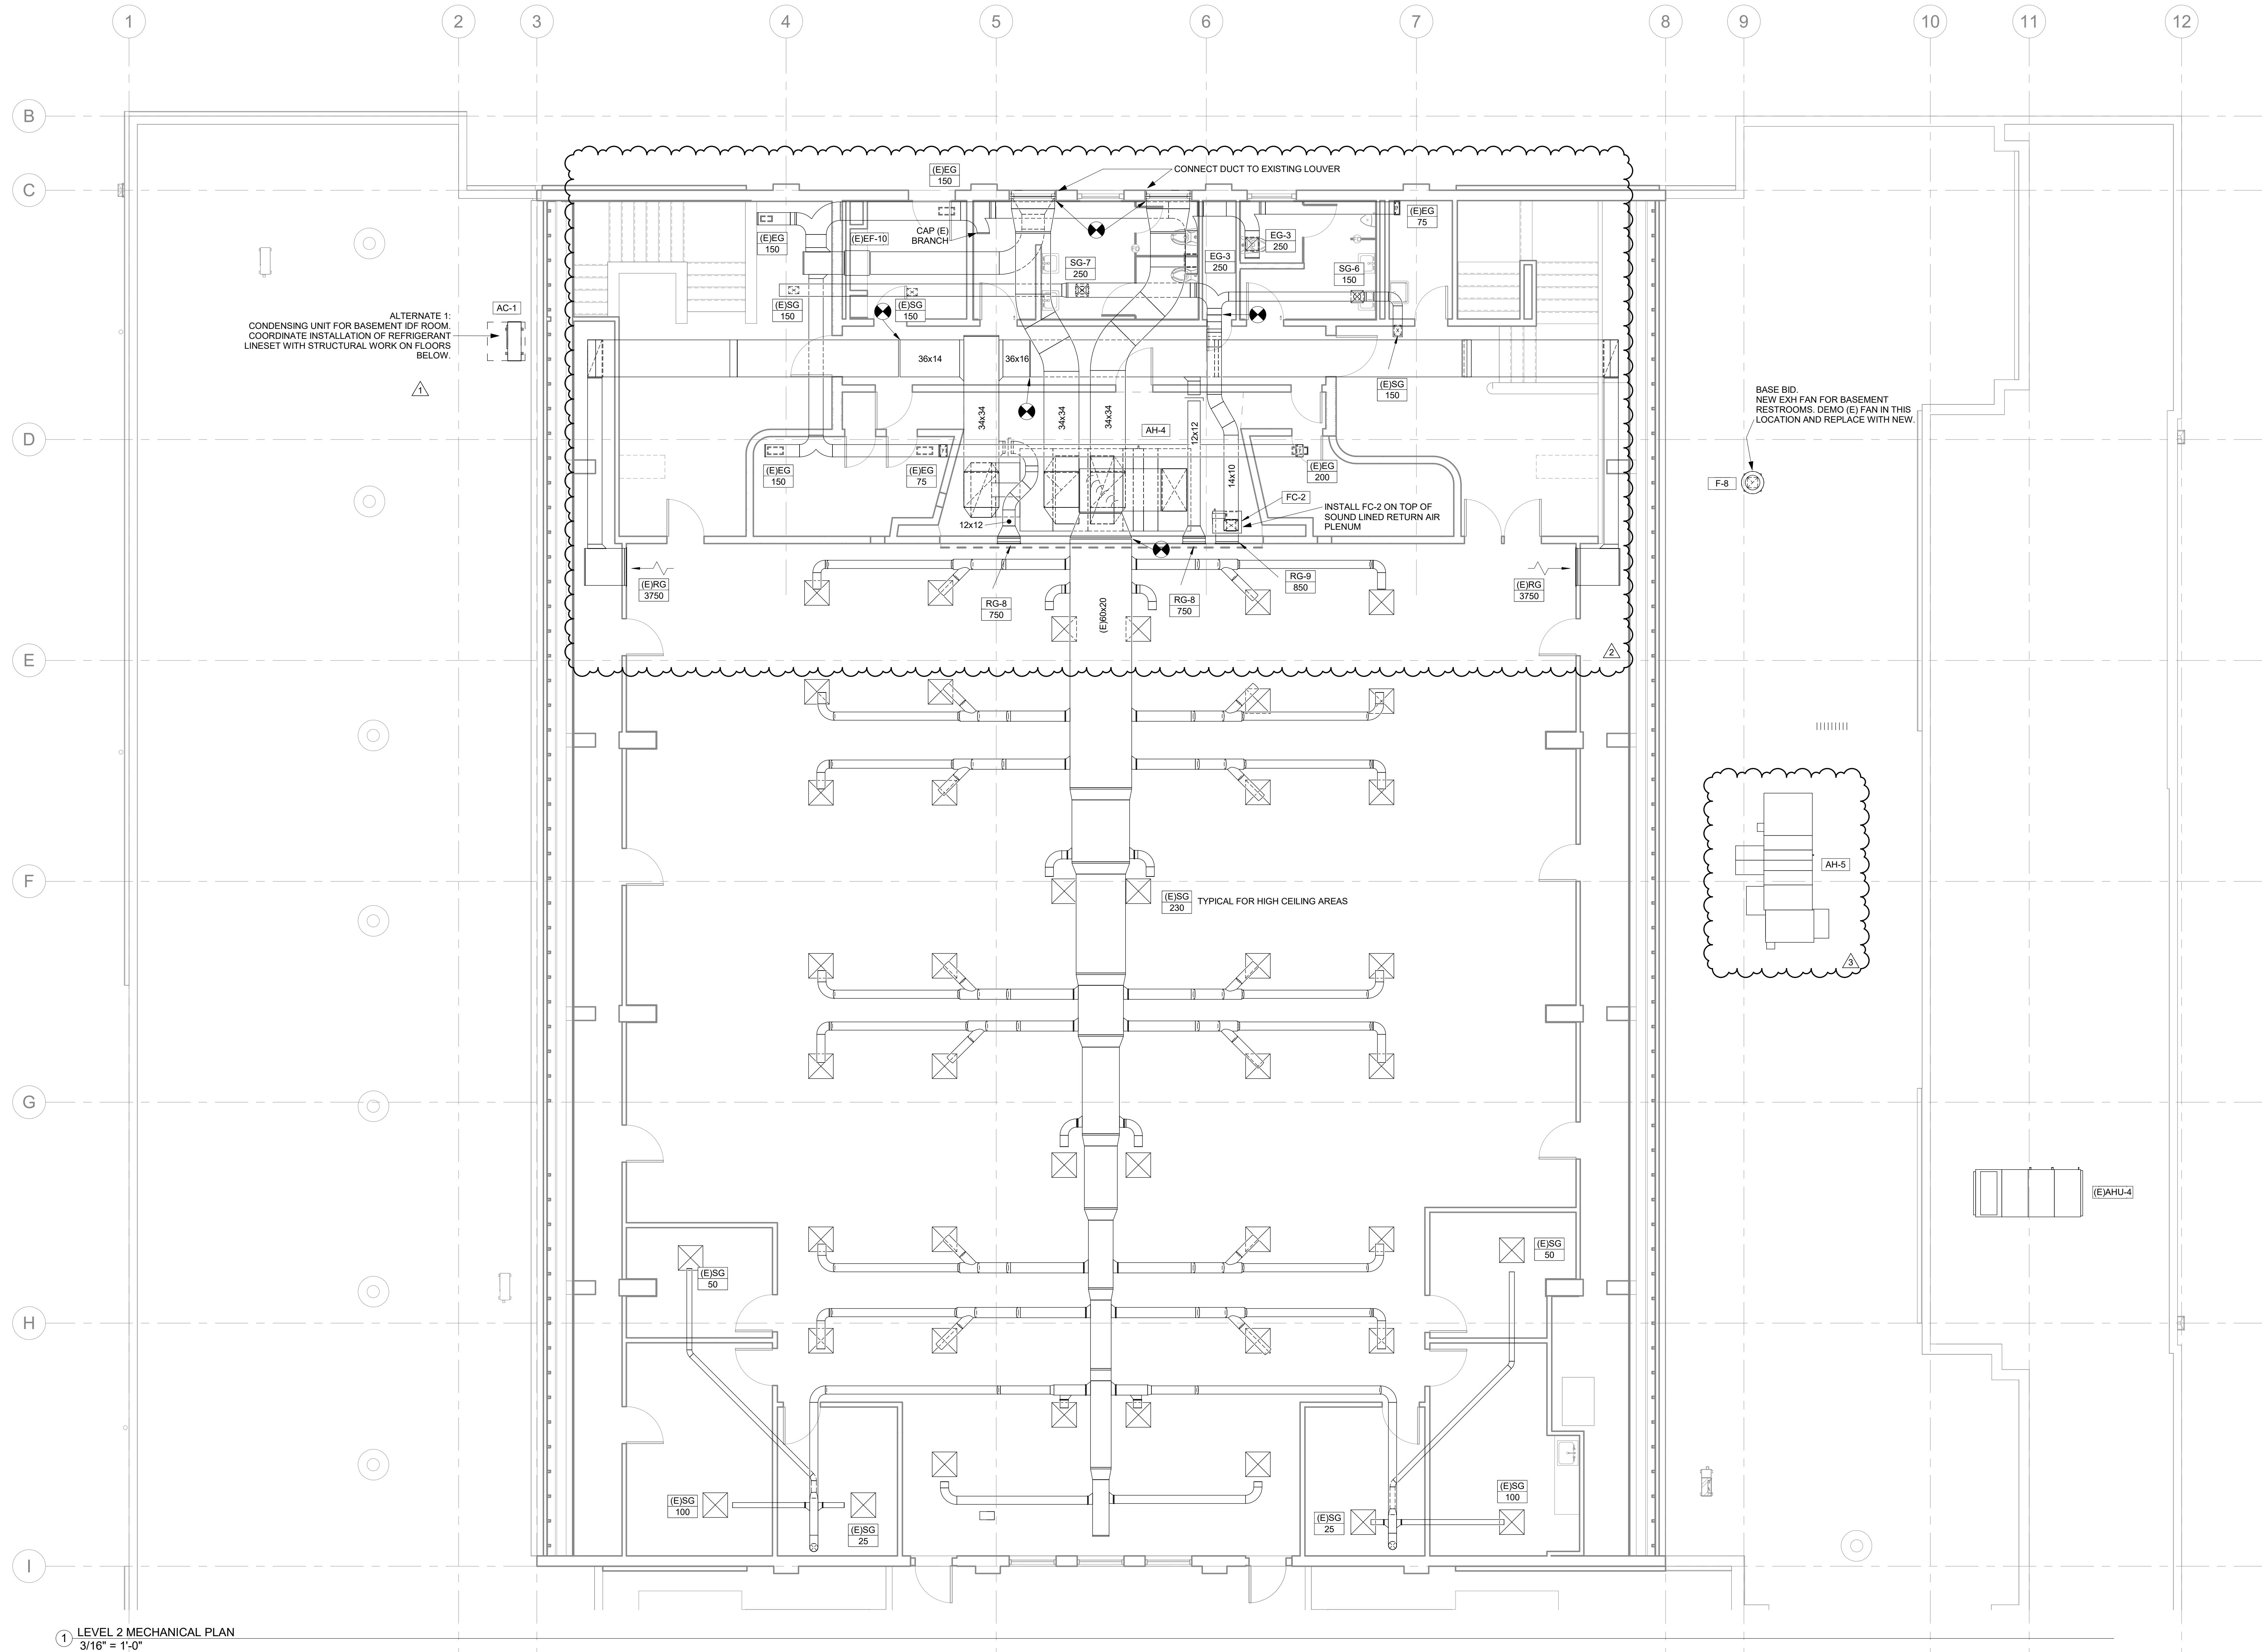

SHEET NOTES


- A. SEE SHEET M2.3 FOR 2ND LEVEL MECHANICAL DEMOLITION
B. SEE SHEET M3.6 FOR 2ND LEVEL MECHANICAL PIPING AND
SECTIONS
C. TEST AND BALANCE ALL NEW AND EXISTING DIFFUSERS AND
GRILLES SERVED BY (E)EF-10, AH-4 AND FC-2.
D. TEST AND BALANCE (E)EF-10 TO 1,300 CFM.

kistler +
small
+ white
architects

66 WATER STREET
SUITE 101
ASHLAND, OR
97520
TEL.: 541.488.8200

THESE DRAWINGS SHALL
BE USED FOR:
CONSTRUCTION
BIDDING
RECORDATION
CONVEYANCE
ISSUANCE OF A PERMIT

PHASE 2
BID SET

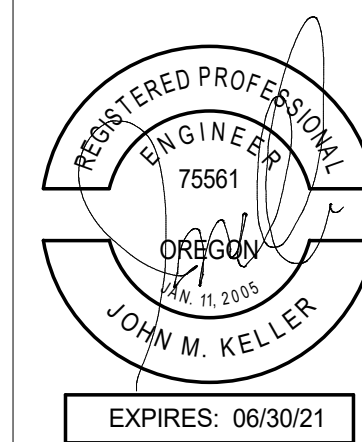

BRITT HALL - RENOVATION
SEISMIC UPGRADE / OHSU RENOVATION - PHASE 2
SOUTHERN OREGON UNIVERSITY
SISKIYOU BOULEVARD, ASHLAND OREGON, 97520


REVISIONS

1	REVISION 1	02.07.2020
2	IB-1	07.24.2020
3	IB-2	07.24.2020


LEVEL 2
MECHANICAL PLAN

PROJECT NO.: 1905
ISSUE DATE: 02.13.2020
SHEET:


M3.5

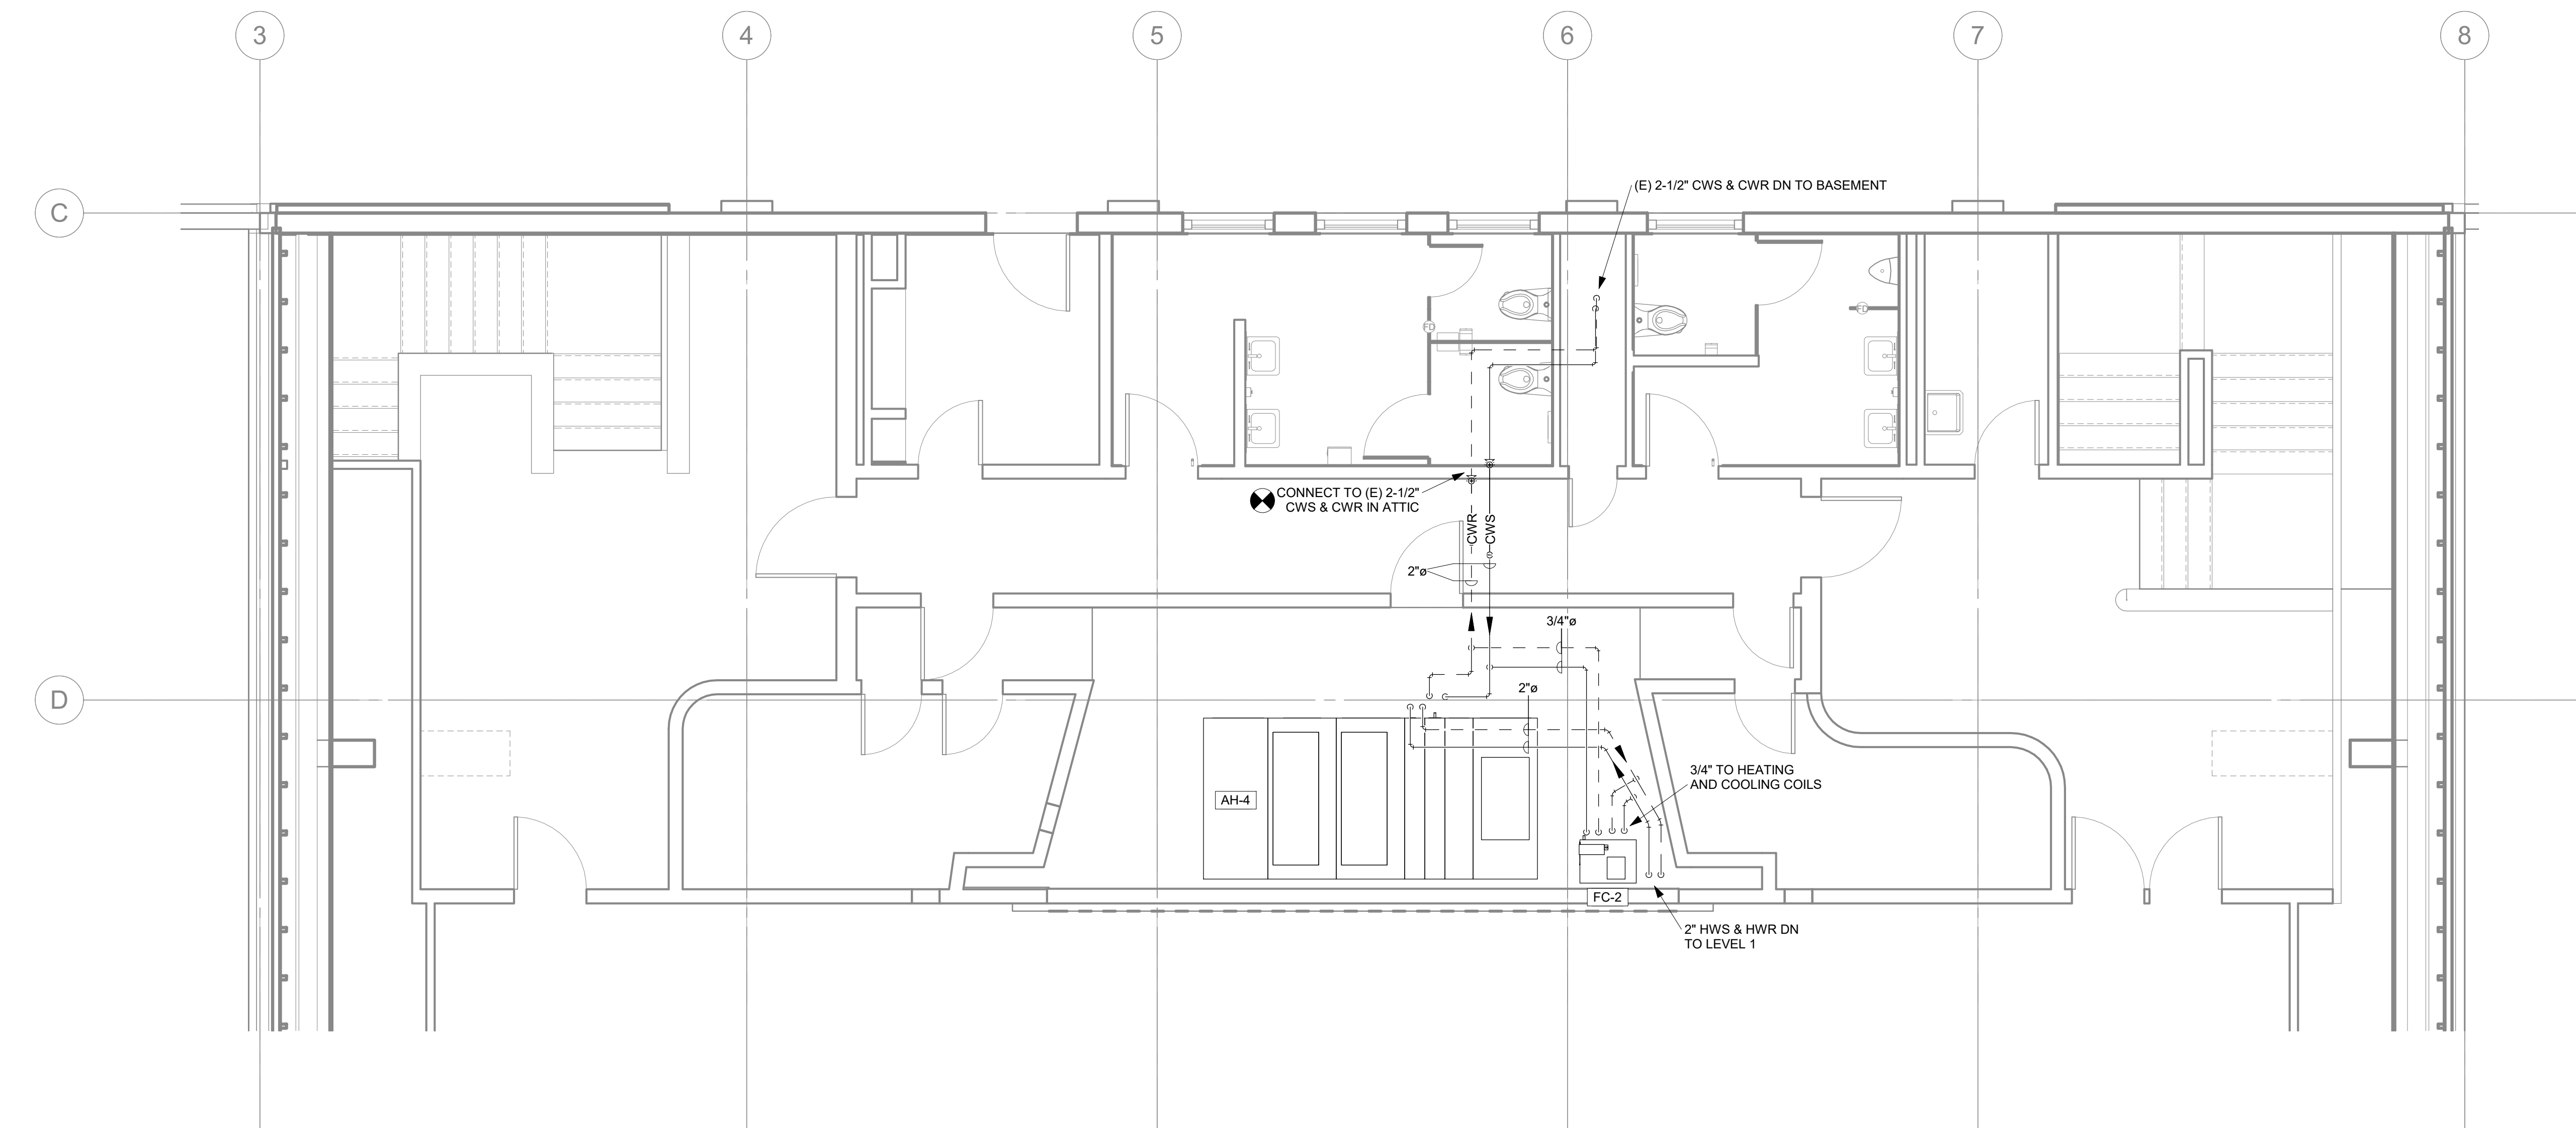

1 LEVEL 2 MECHANICAL PIPING PLAN
1/4" = 1'-0"

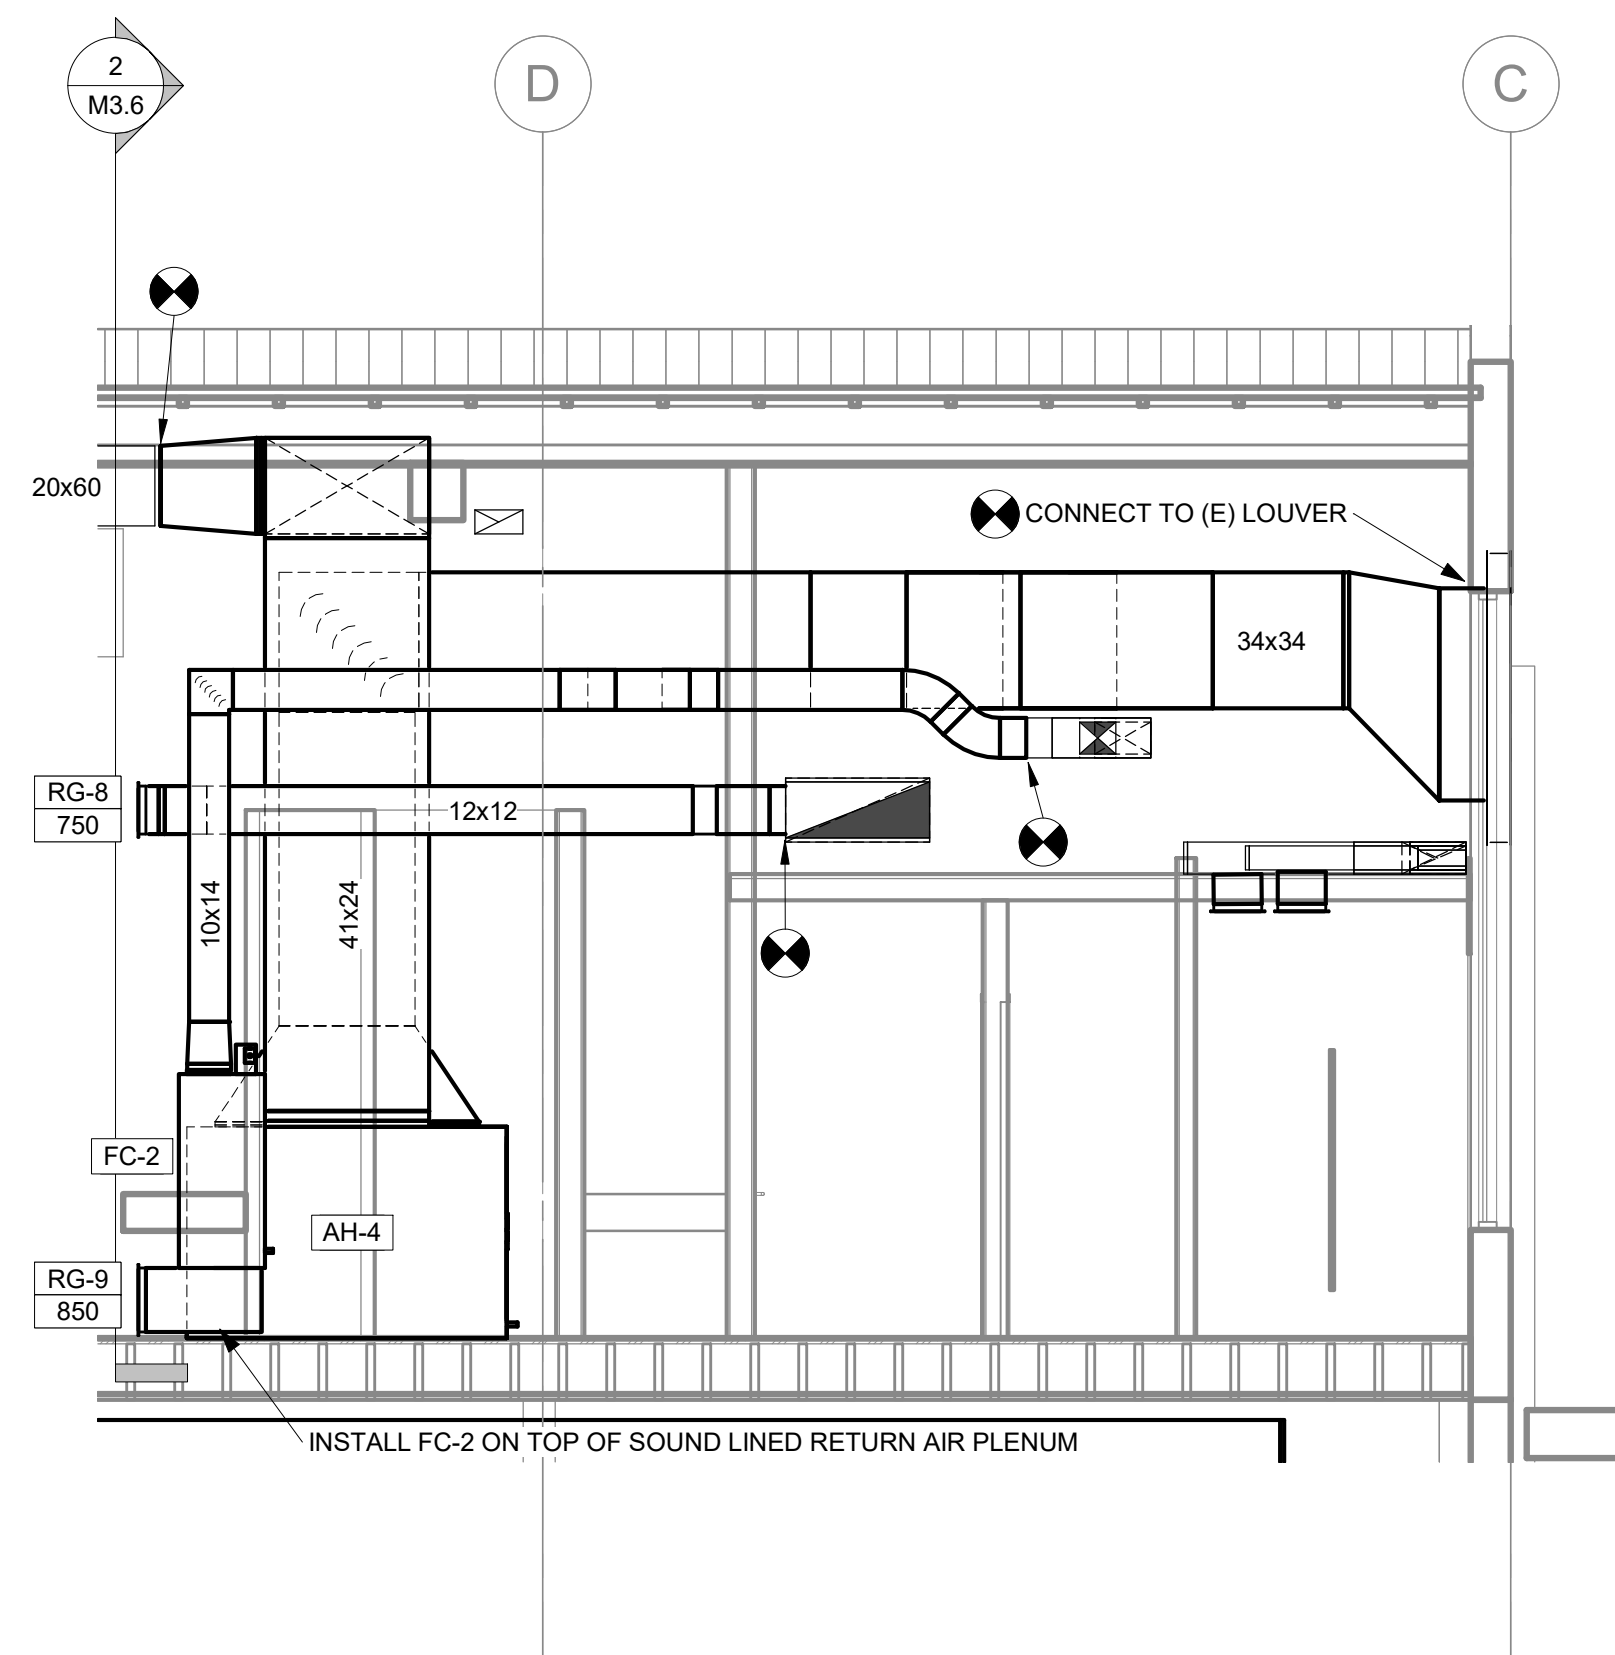

3 AH-4 CROSS SECTION
1/4" = 1'-0"

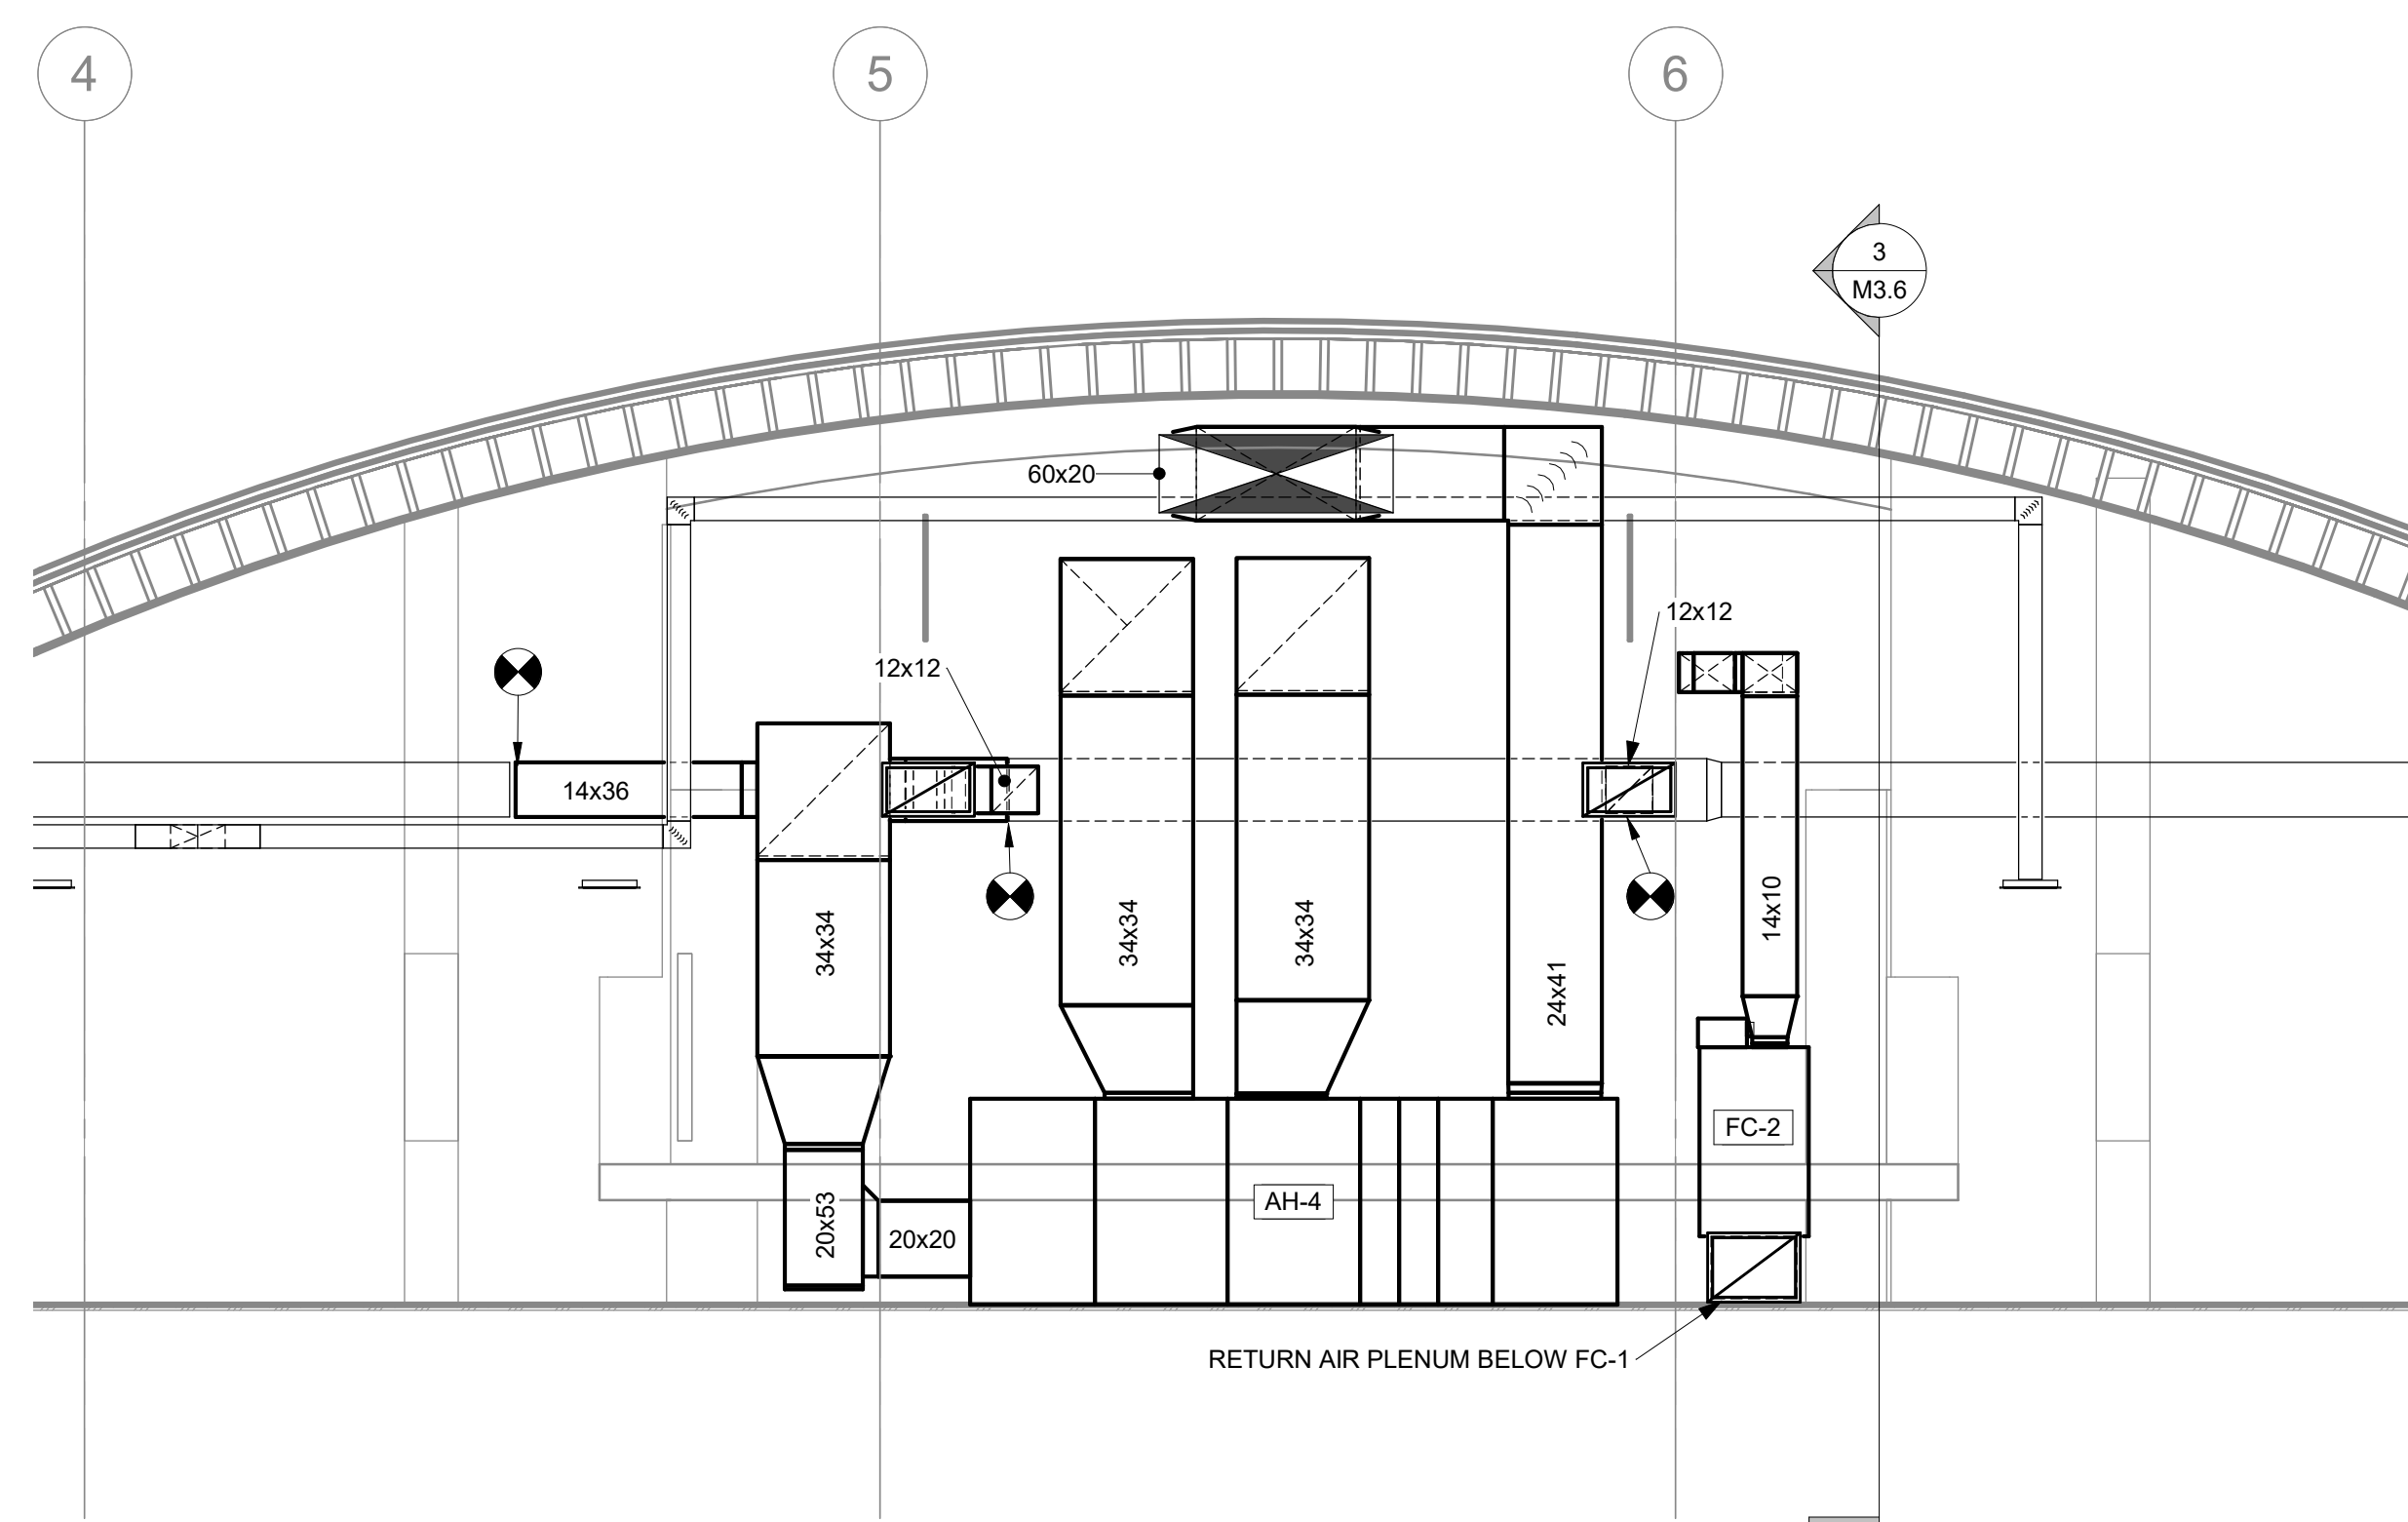

2 AH-4 SECTION
1/4" = 1'-0"

SHEET NOTES


- A. ALL WORK ON THIS SHEET IS ALTERNATE 3.
B. SEE SHEET M2.3 FOR LEVEL 2 MECH DEMOLITION.
C. SEE SHEET M3.5 FOR LEVEL 2 DUCTWORK.

kistler +
small
+ white
architects

66 WATER STREET
SUITE 101
ASHLAND, OR
97520
TEL.: 541.488.8200

THESE DRAWINGS SHALL
BE USED FOR:
CONSTRUCTION
BIDDING
RECORDATION
CONVEYANCE
ISSUANCE OF A PERMIT

PHASE 2
BID SET

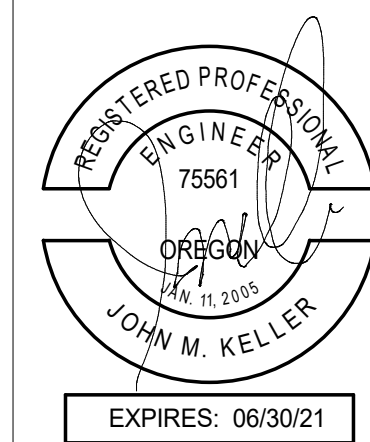

BRITT HALL - RENOVATION
SEISMIC UPGRADE / OHSU RENOVATION - PHASE 2
SOUTHERN OREGON UNIVERSITY
SISKIYOU BOULEVARD, ASHLAND OREGON, 97520

REVISIONS
2 IB-1 07.24.2020

LEVEL 2
MECHANICAL
PIPING PLAN AND
SECTIONS

PROJECT NO.: 1905
ISSUE DATE: 02.13.2020
SHEET:

M3.6



- A. PUMP/SIZING / DESIGN INTENT: THE TWO PUMPS SHALL OPERATE IN A LEAD / STANDBY MODE WITH 100% REDUNDANCY. WHEN THE REMAINING STEAM HEAT AIR HANDLERS ARE CONVERTED TO OPERATE IN STANDBY MODE, A THIRD PUMP WILL BE ADDED AND THE PUMPS WILL OPERATE IN A LEAD/LAG/STANDBY MODE WITH 50% REDUNDANCY.
- B. THE STEAM TO HOT WATER CONVERTER IS SIZED TO PROVIDE HEATING HOT WATER TO THE ENTIRE BUILDING. IT IS NOT TO BE CAUGHT FOR THE FUTURE CONVERSION OF THE REMAINING STEAM AIR HANDLERS TO HOT WATER HEAT.
- C. WHEN COIL IS INCLUDED IN CASING MOUNTED ON VIBRATION ISOLATORS THE FIRST 2 HANGERS FOR EACH PIPE SHALL BE SPRING & NEOPRENE TYPE.
- D. PIPING SHALL BE INSTALLED IN SUCH MANNER THAT IT WILL NOT BLOCK THE FLOW OF AIR OR WATER. IT SHALL BE INSTALLED IN SUCH MANNER THAT IT BLOCKS THE SERVING OF FILTERS, VALVES, OR EQUIPMENT.
- E. SEE EXPANSION TANK SYSTEM SCHEDULE FOR COMPONENT SIZES.
- F. PROVIDE UNIONS FOR THE REMOVAL OF VALVES WITH SCREWED CONNECTIONS.


BID SET






BRITT HALL - RENOVATION
SEISMIC UPGRADE / OHSU RENOVATION - PHASE 2
SOUTHERN OREGON UNIVERSITY
SISKIYOU BOULEVARD, ASHLAND OREGON, 97520

PROJECT NO.: 1905
ISSUE DATE: 02.13.2020
SHEET:

M4.1

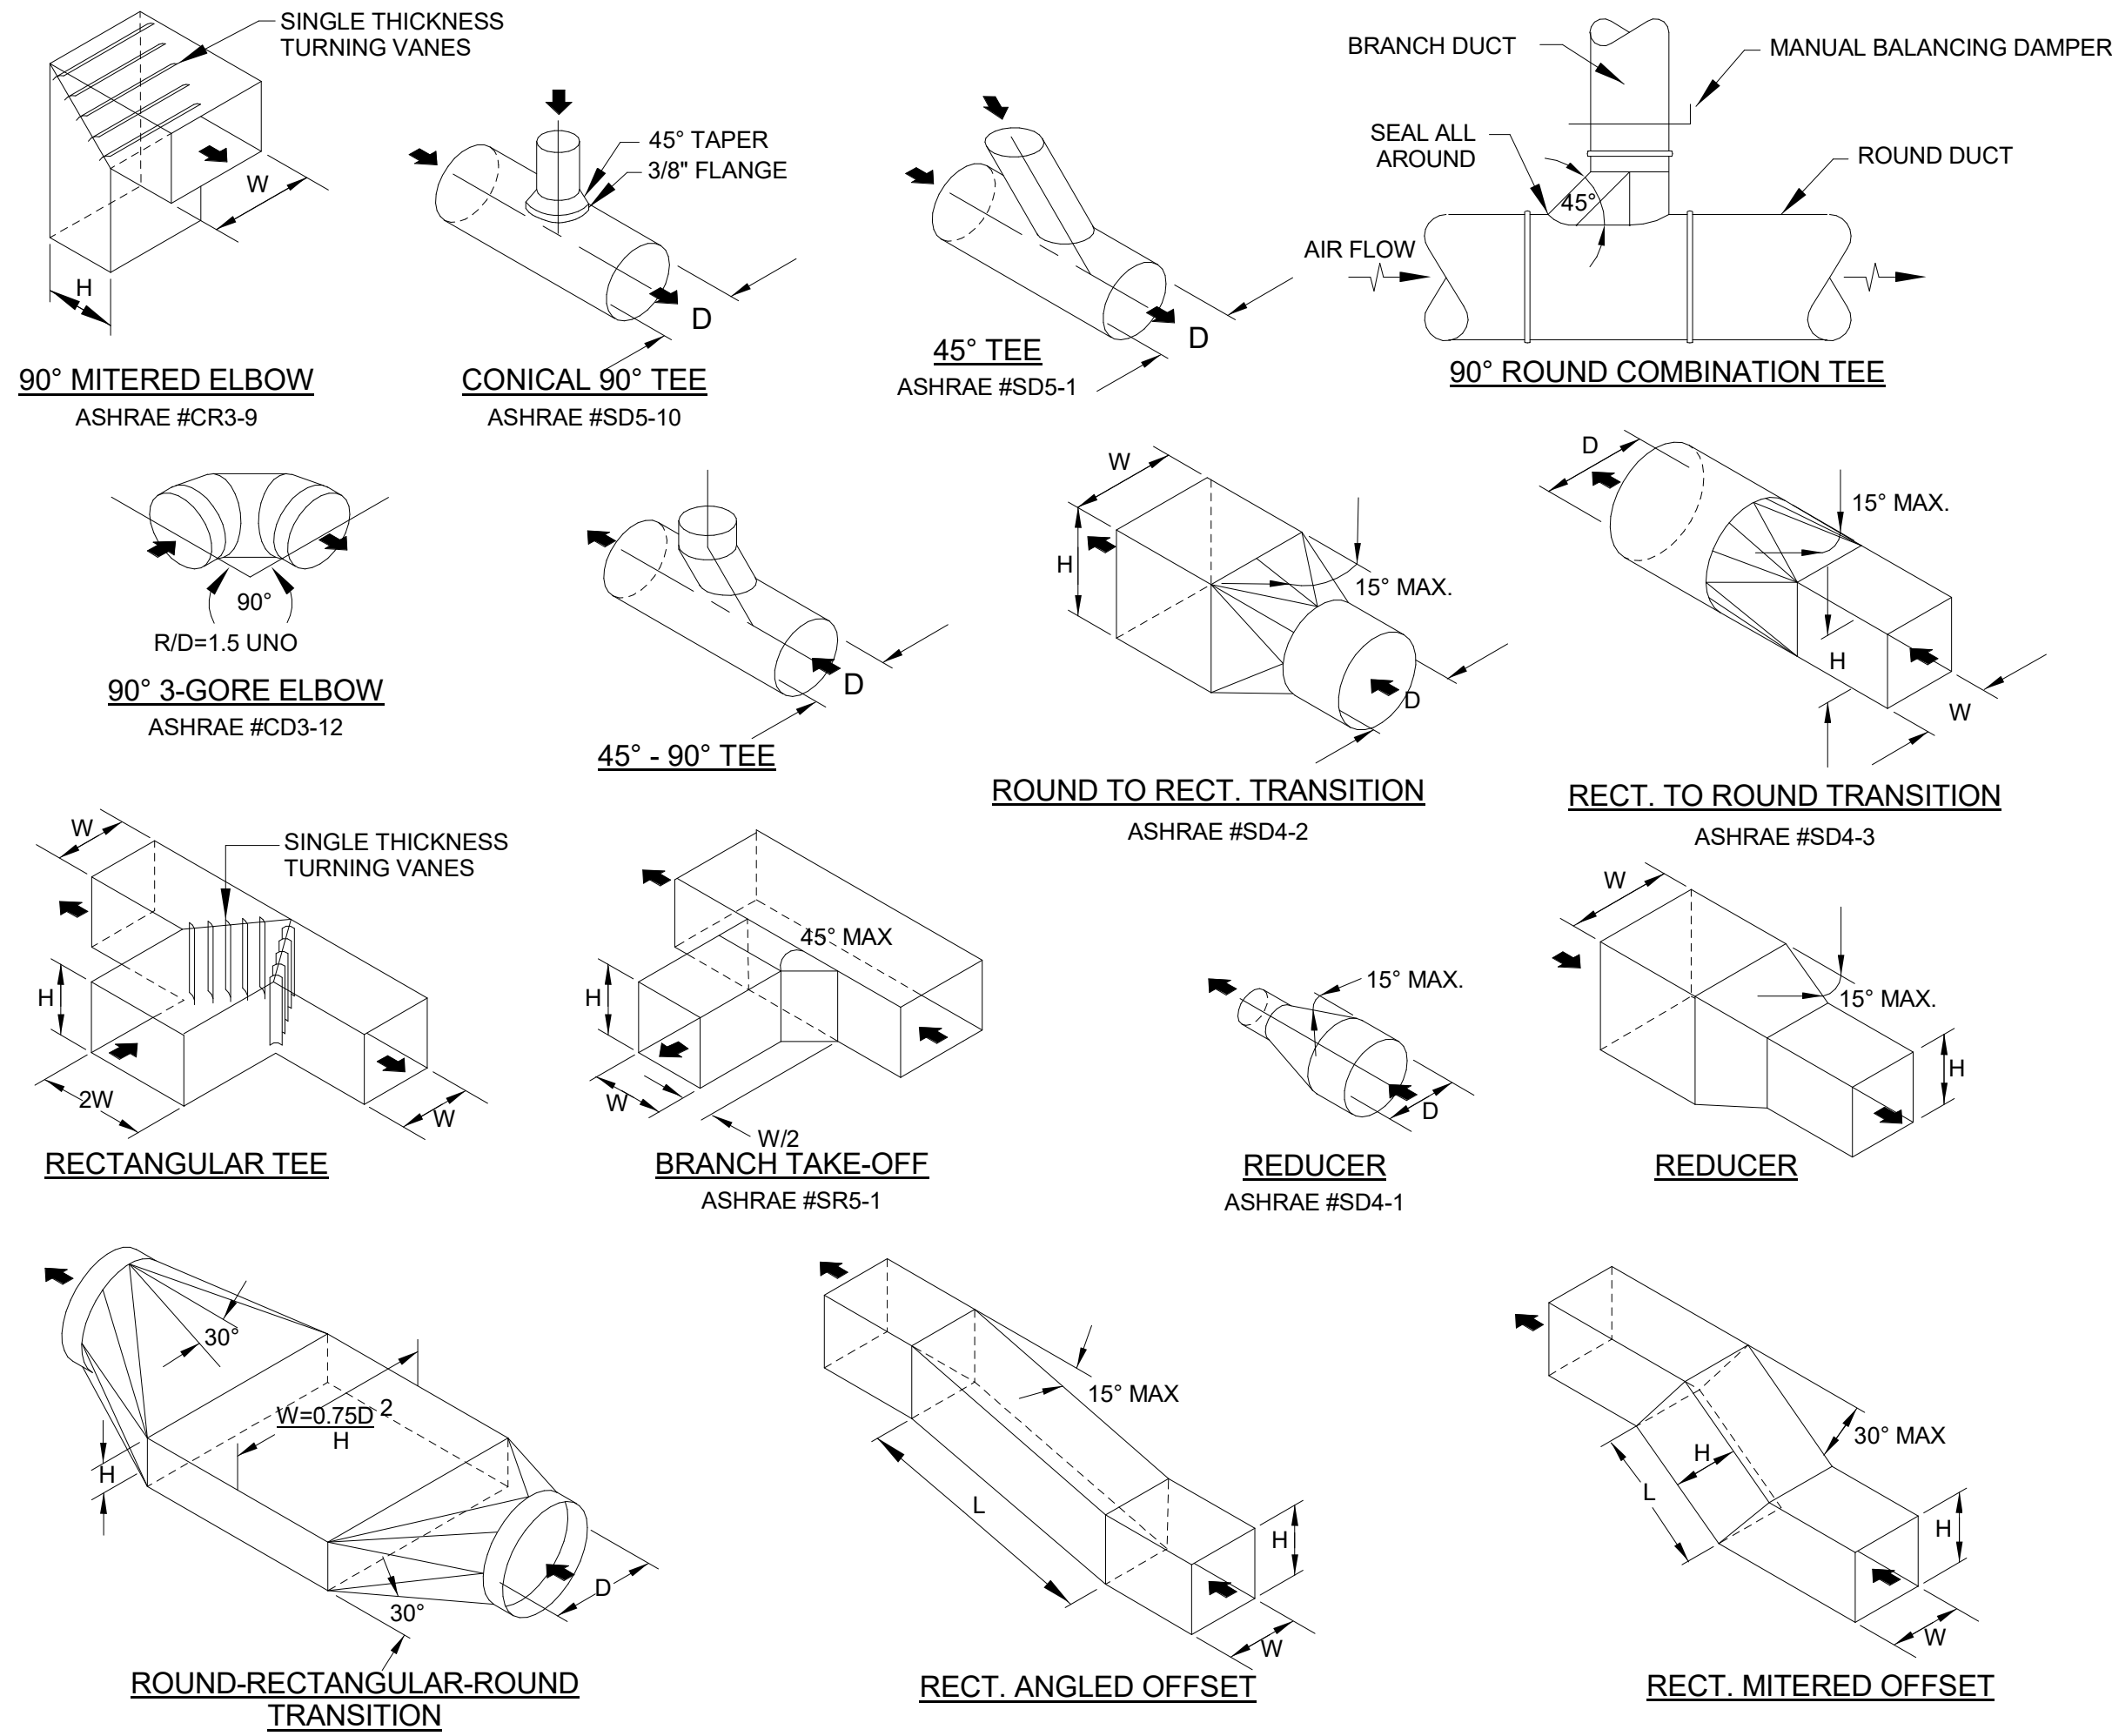




6 LOW PRESSURE DUCT CONSTRUCTION DETAILS
NTS

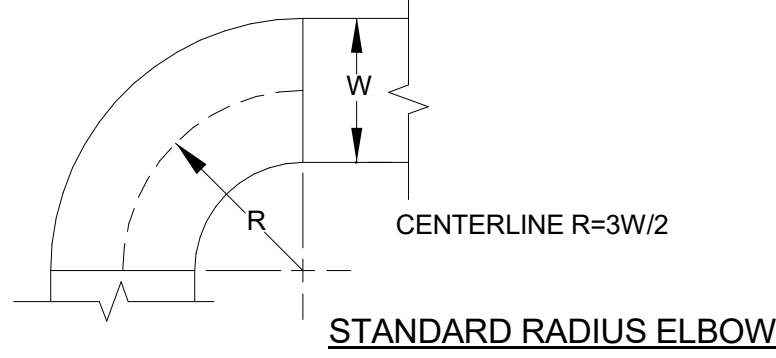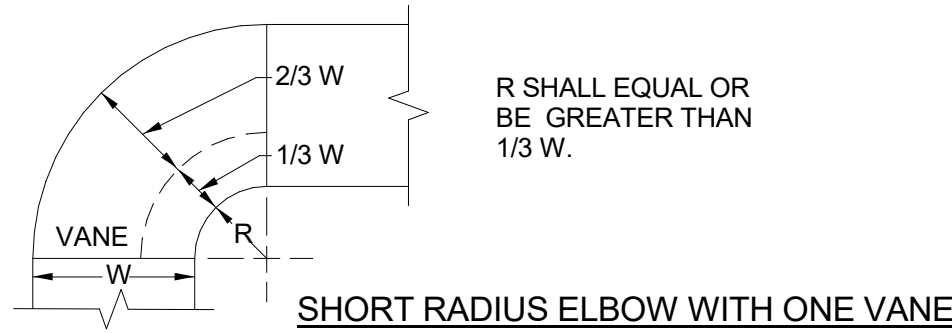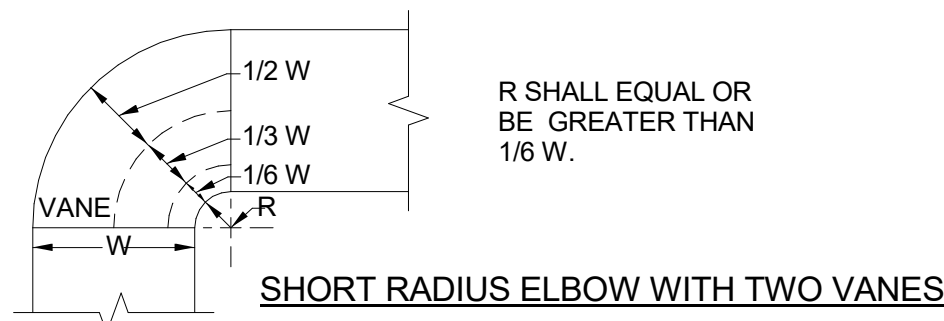

NOTES:

1. THIS DETAIL APPLIES TO RECTANGULAR DUCT ONLY.
2. THE INTERIOR SURFACE OF ALL RADIUS ELBOWS SHALL BE MADE ROUND.
3. ALL STANDARD RADIUS ELBOWS SHOWN ON DRAWINGS MAY BE MADE SHORT RADIUS ELBOWS. ALL SHORT RADIUS ELBOWS SHALL HAVE VANES. VANES SHALL BE CONSTRUCTED, SUPPORTED AND FASTENED AS RECOMMENDED BY SMACNA.


5 RADIUS ELBOWS
NTS

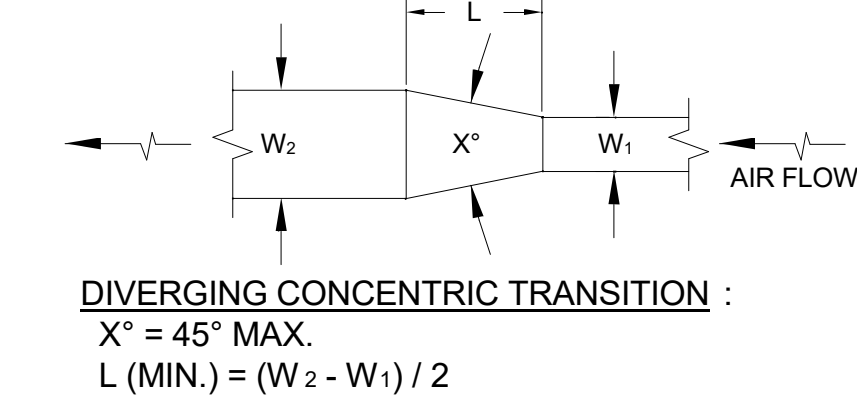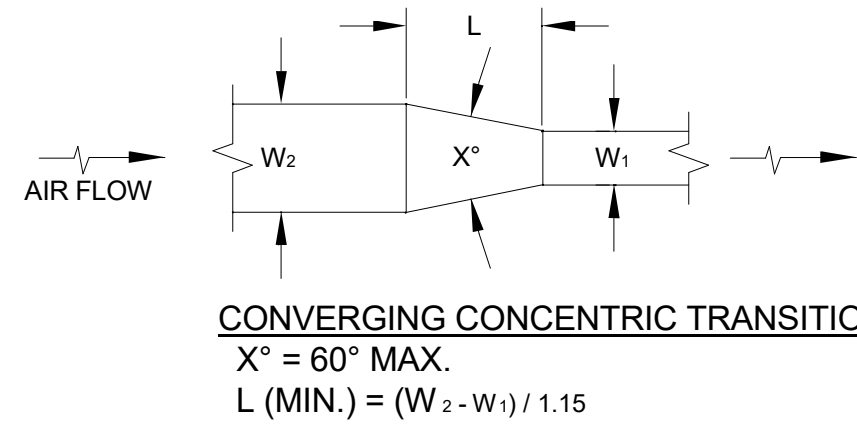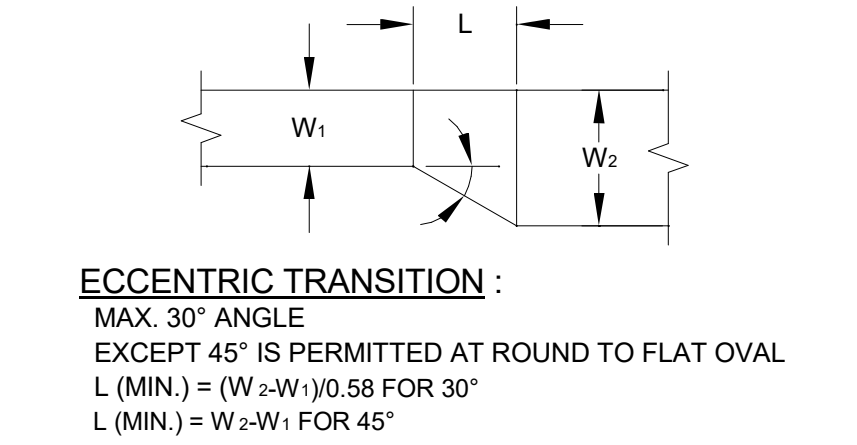


NOTE:

1. UNLESS OTHERWISE INDICATED ON PLANS, MAXIMUM ANGLES SHOWN SHALL APPLY.


4 DUCT TRANSITIONS
NTS

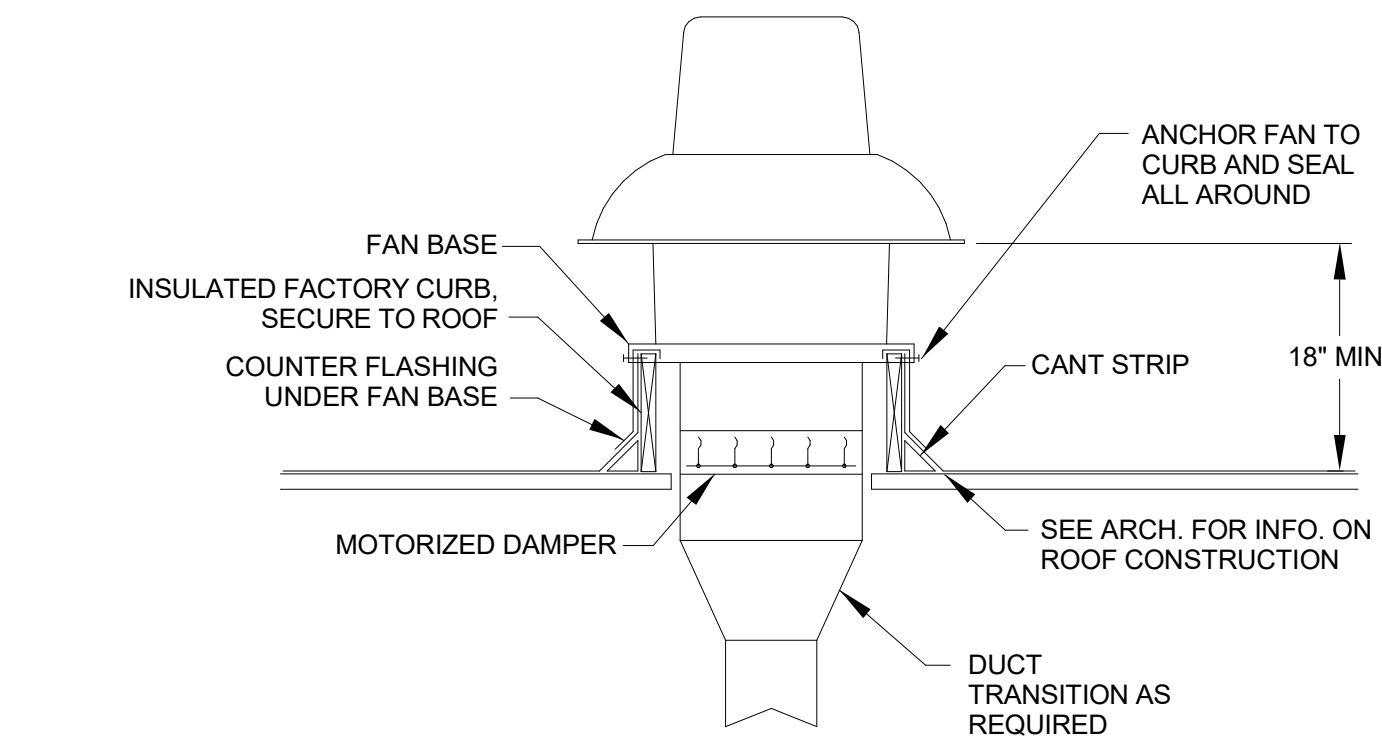

1 ROOF MOUNTED EXHAUST FAN
NTS

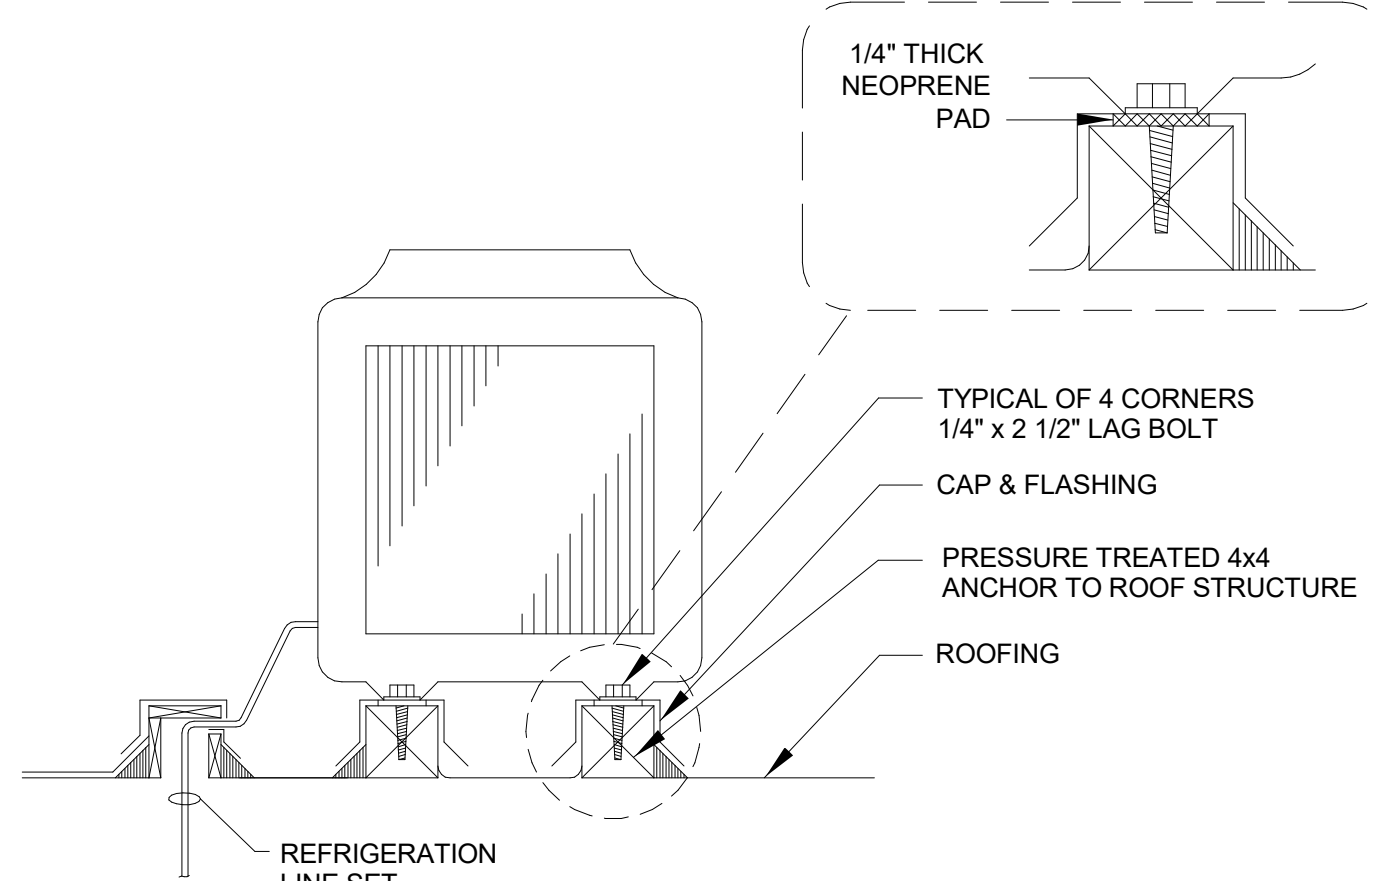

2 OUTDOOR HEAT PUMP UNIT
NTS

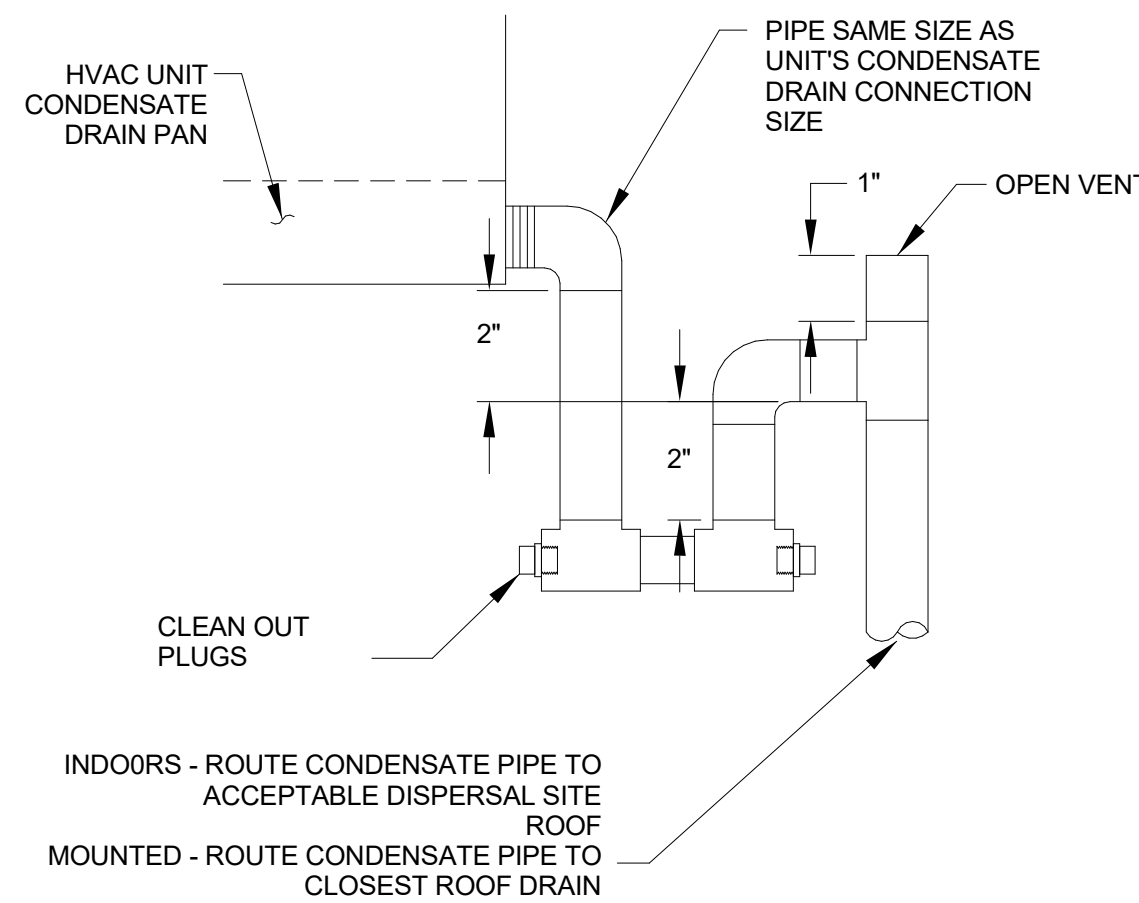

3 CONDENSATE TRAP DETAIL
NTS